
FORM 51

Stafford KANSAS

Section 9 Township 22 Range 13 W

Well No. # 1 Keller

Company Hulme Drlg.

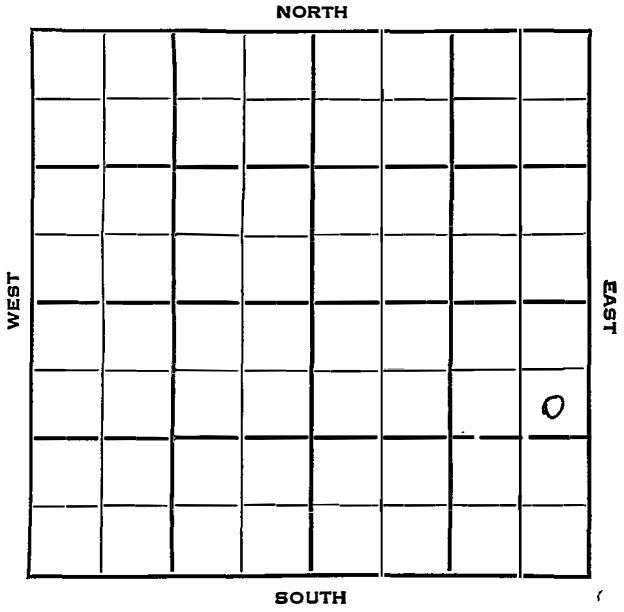

Stafford KANSAS

SEC.	TWP.	R.
9	22	13W

WELL NO.

#1 Keller FARM
COMPANY

Hulme Drlg.
CONTRACTOR

Hulme Drlg.


Silver Bell Pool

990 Ft. from N. Line

Ft. from S. Line

330 Ft. from E. Line

Ft. from W. Line

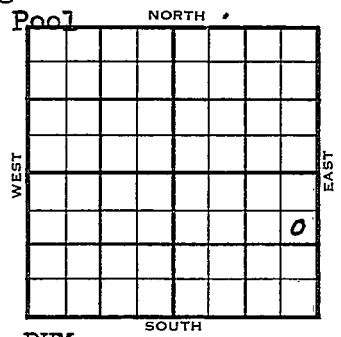

SE NE SE

McWilliams & Steincamp - DHM

1953	ELEVATION 1897' REPORT
12/22	Spud 12-15-53 8" @ 300' Drlg 2980'
1954 1/6	Spud 12-15-53 D & A TD 3820' 8" @ 300' Br. Lime 3391', Lans 3412', DST 3599'-3638' opn ½ hr, rec 18' Mud 75# Viola 3702', Simp 3759' Arb 3809' TD 3820' D & A

ABANDONED

DX-78

FORM 275 FOR SALE BY KANSAS BLUE PRINT CO.


County Stafford State Kansas

Sec. 9 (Blk. Twp.) 22 (Sur. Rge.) 13W Map No.

Operator Hulme Drlg.

Well No. 1 Farm Keller

Elev. 1897 Location SE NE SE

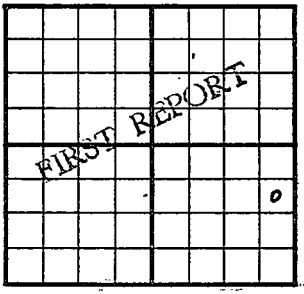

990 Ft. From N Line SE

330 Ft. From E Line Quarter

1st. Report DEC 22 1953

Completion

Remarks McWilliams & Stein- Camp Drlg
Hulme Drlg. - Contr.

Spudding Date 12-15-53

Drlg. Data Silver Bell Pool

8" @ 300 drlg. 2980

J. G. McGEHEE

FORM 275 FOR SALE BY KANSAS BLUE PRINT CO.


County Stafford State Kansas

Sec. 9 (Blk. Twp.) 22 (Sur. Rge.) 13W Map No.

Operator Hulme Drlg.

Well No. 1 Farm Keller

Elev. 1897 Location SE NE SE

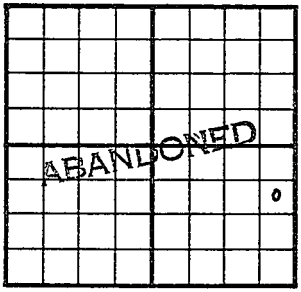

990 Ft. From N Line SE

330 Ft. From E Line Quarter

1st. Report

Completion JAN 6 1954

Remarks Silver Bell Pool

Hulme Drlg. - Contr.

Spudding Date 12-15-53

Drlg. Data D & A TD 3820

8" @ 300 Br. lime 3391 Lans. 3412

DST 3599-3638 open ½ hr. Rec. 18' mud

75# Viola 3702 Simp. 3759 Arb. 3809

TD 3820

D & A

J. G. McGEHEE