


Section 9 Township 22 Range 13 W

Well No. #1 Kelley

Company Petroleum Inc.

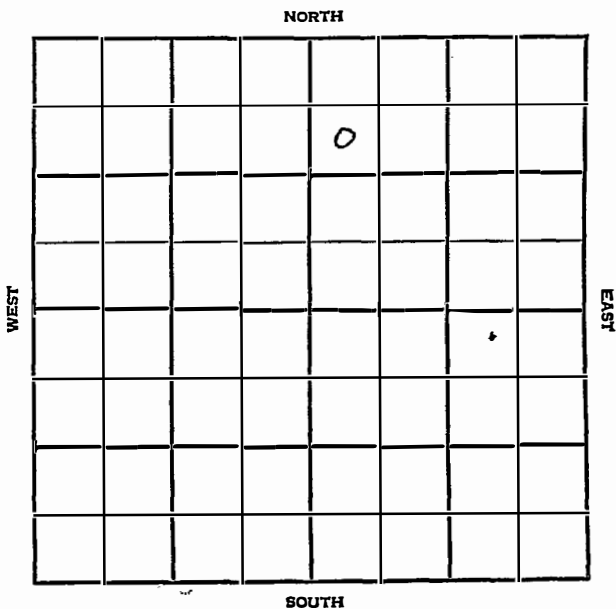

Stafford

KANSAS

SEC.	TWP.	R.
9 -	22	13W

WELL NO.

#1 Kelley

FARM

COMPANY

Petroleum Inc.

CONTRACTOR

Co. Tools

Silver Bell


_____ Ft. from N. Line

_____ Ft. from S. Line

_____ Ft. from E. Line

_____ Ft. from W. Line

SW NW NE

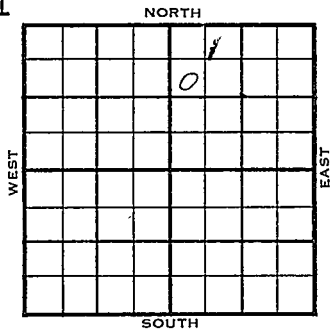

	ELEVATION	REPORT
1956		

2-22

Comm. 2-14-56
 8" @ 280/225
 Drlg. 3572
 H. 3253
 BL. 3380
 L. 3398

County Stafford Elev. 1895
 Sec. 9 Twp. 22 Rge. 13W
 Company Petroleum Inc.
 Farm Name Kelley No. 1

TOPS	DEPTH	LOG	DATUM
Anh.			
TP.			
H.	3253		
Tr.			
Dg.			
Bl.	3380		
L.	3397		
K.C.			
B.K.C.			
Ce.			
C.			
M.			
M.			
K.			
Mz.			
Me.			
V.			
S.			
S.			
A.			
R.			
PE.			
G.			
T.D.			

Loc. in Sec. SW NW NE

Geol. _____
 Contr. Co. tools

Pool Silver Bell

0

FEB 22 '56

FIRST REPORT

Date Comm. 2-11-56
8" @ 280/225 drlg. 3572

~~13~~

Co.
Lse.
No.
Sec.
T.
R.

27

County	Stafford	Elev.	1895
Sec.	9	Tap	(22) 13W
Company	Petroleum Inc.		
Farm Name	Kelley		No. 1

TOPS	DEPTH	LOG	DATUM	Loc. in Sec.
Ant.				SW NW NE
TP				
H.	3253			
Tr.				
Dp.				
BI	✓ 3380		1415	
L.	✓ 3397		1502	Geol.
K.C.				
BXC.				Contr.
Ce.				Co. tools
C.	3652		1757	
M.				Pool
M.				Silver Beal
K.				
Me.				
Mo.				
V.	3670		1775	<div style="border: 1px dashed black; width: 100px; height: 100px; margin: auto;"> o </div>
S.	3734		1839	
S.				
A.	✓ 3784		1889	
R.				
PE.				ABANDONED
G.				
TA.	3797			

Date Comm. 2-14-56 FEB 29 1956

8" @ 280/225 drlg. 3572 FEB 29 55 X

DST 3577-3605 or 30" sec
 10' MD BHP 1200 RTD 3797

H.C.A.