

Section 9 Township 22 Range 14WWell No. #1 Stroble "A"Company Petroleum Inc.

NORTH

	0						

WEST

EAST

SOUTH

Sec. 9 Twp. 22 R. 14W

Well No. #1 Stroble "A" Farm

Petroleum Inc.

Company

Garvey

Contractor

Ft. from N. Line

330


Ft. from S. Line

Ft. from E. Line

990

Ft. from W. Line

SE SW NW

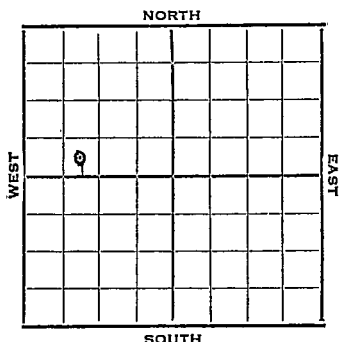

1952 Elev. 1948' REPORT

9/24 MTM
10/1 8" @ 220'
Anhy 833'
Drlg. 3029'
10/8 Heeb. 3342 Br Li 3464
Lans. 3474
DST 3593-3610 ppen 1 hr. rec. 65'
SOCM 90' HOCM 30' wtr. & acm
DST 3626-42 open 1/2 hr. rec. 10'
mud, DST 3657-3700 open 1 hr.
rec. 890' oil 360' gassy oil
Simp. 3812 Arb. 3872
DST 3874-77 open 1 hr. rec. 6' mud
5" @ 3876'
10/15 DD 3878 1000A 10 BWPH
16/3659-63 1 BOPH 500A
S/10 BOPH
10/22 No report
10/29 S/11 BOPH off Btm est 250 bopd POP
11/5 NR
11/12 "
11/19 Spud 9-24-52
Oil Well
TD 3878'

OVER

1952 (Information Brought Forward)

11/19

8" @ 220

Anhy 833, Heeb. 3342, Br. 1m
3464, Lans. 3474

DST 3593-3610, opn 1 hr., rec.
65' socm, 90' hocm, 30' w & ocm

DST 3626-42, opn $\frac{1}{2}$ hr., rec.
10' mud

DST 3626-42, opn $\frac{1}{2}$ hr., rec. 10
mud

DST 3657-3700, opn 1 hr., rec.

890' oil, 360' gassy oil

1290#

Simp 3812, Arb. 3872

DST 3874-77, opn 1 hr., rec.

6' mud

5" @ 3876

TD 3878,

500A, NS 500A 10 bwph

16/3659-63, 1 boph 500A

S/10 boph S/11 boph

Comp. 427 bopd

COMPLETED

County Stafford State KansasSec. 9 (Blk.) 22 (Sur.) 14W Map No.Operator Petroleum Inc.Well No. 1 Farm Stroble "A"Elev. Location SE SW NW

330 Ft. From S Line NW990 Ft. From W Line Quarter1st. Report SEP 24 1952

Completion

Remarks

Garvey - Contr.


Spudding Date

Drig. Data

M I M

J. G. McGEHEE

County Stafford State Kansas
 Sec. 9 (Blk. 22) (Sur. 14W) Map No. 14W
 Operator Petroleum Inc.
 Well No. 1 Farm Stroble "A"
 Elev. 1948 Location SE SW NW

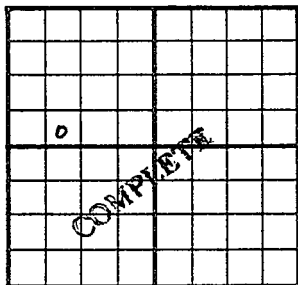

330 Ft. From S Line NW
990 Ft. From W Line Quarter
 1st. Report NOV 19 1952
 Completion NOV 19 1952
 Remarks Garvey - Contr.
 Spudding Date 9-24-52

Drlg. Data Oil well TD 3878
8" @ 220 Anhy 833 Heeb. 3342
Br. lime 3464 Lans. 3474 DST 3593-3610
open 1 hr. Rec. 65' socm 90' hoom
30' w & ocm DST 3626-42 open 1/2 hr.
Rec. 10' mud DST 3657-3700 open 1 hr.
Rec. 890' oil 360' gassy oil 1290#
Simp. 3812 Arb. 3872 DST 3874-77
open 1 hr. Rec. 6' mud 5" @ 3876
TD 3878 500 A ns 500 A 10 bwph
16/ 3659-63 1 boph 500 A S/ 10 boph
S/ 11 boph Comp. 427 bopd

J. G. McGEHEE