


Section 9 Township 22 Range 14W

Well No. #1 Stroble

Company Petroleum, Inc.

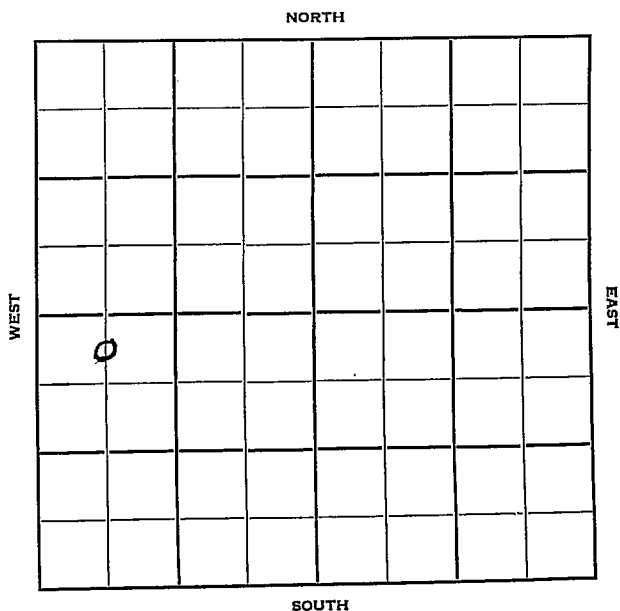



Sec. 9 Twp. 22 R. 14 W

Well No. # 1 Strobble Farm

Petroleum Inc. Company

Contractor

Wildcat


330 Ft. from N. Line

Ft. from S. Line

Ft. from E. Line

660 Ft. from W. Line

C N/2 NW SW

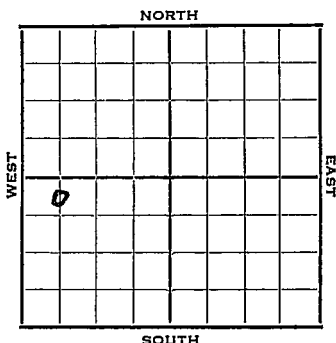

1952 Elev. 1947' REPORT

7/16 Spud 7-7-52
8" @ 243' Heeb 3336' Tor. 3457'
Lans. 3466'
DST 3582-3603 1 hr, 60' OCM, 120' HOCM
240' free oil 1200#
DST 3607-39, 1 hr, 30' SOCM, 30' OCM
0# Double packer
DST 3449-92, 1 hr, 360' gas, 45' HOCM
45' V HOCM, 255' muddy oil 1050#
V 3763' Simp. 3805'
Drlg.

7/23 DST 3789-3842, 1 hr. 125' md
200# Arb. 3861
DST 3863-66, 1 hr. 92' VHOCM 1225#
DST 3866-79, 1 hr. 950' oil & 90'
HOCM 1075# RTD 3911
5" @ 3910 WOCT

7/30 CO 16/3864-68 16/3868-72
2 1/2 Boph 100 A

8/6 P/500 BOPD & trace

8/13 NR

8/20 "

8/27 Spud 7-7-52
OilWell TD 3911' 8" @ 243
Heeb. 336 Tor. 3457
Lans. 3466
DST 3582-3603 open 1 hr. rec. 60'
ocm 120' hocm 240' free oil 1200#

OVER

1952

8/27

DST 3607-39 open 1 hr. rec. 30'
socm 30' ocm 0#

DST 3646-93 open 1 hr. rec. 360'
gas 45' hocm 45' vhocm 255' muddy oil
1050# Viola 3763 Simp. 3805

DST 3789-3842 open 1 hr. rec. 125' mud
200# Arb. 3861

DST 3863-66 open 1 hr. rec. 92' vhocm
1225#

DST 3866-79 open 1 hr. rec. 950' oil
90' hocm 1075# TD 39111

5" @ 3910 16/ 3864-68 16/ 3868-72
2½ boph 100 A P/ 500 bopd

Comp. 100 bopd


COMPLETED

County Stafford State Kansas
 Sec. 9 (Blk.) 22 (Sur.) 14W Map No.

Operator Petroleum Inc.

Well No. 1 Farm Stroble

Elev. 1947 Location C N/2 NW SW

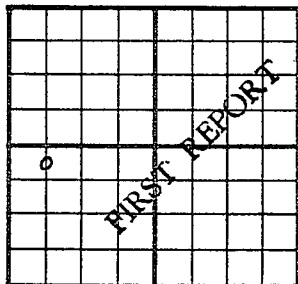

330 Ft. From N Line SW

660 Ft. From W Line Quarter

1st. Report JUL 16 1952

Completion

Remarks

Spudding Date 7-7-52

Drlg. Data Wildcat

8" @ 243 Heeb 3336 Tor 3457 Lens 3466

DST 3582-3603 1hr. 60' ocm 120' Hocm 240'

free oil 1200# DST 3607-39 1 hr. 30' soem

30' ocm 0# Double packer DST 3449-92


1 hr. 360' gas 45' Hocm 45' V Hocm

255' muddy oil 1050# V 3763 Simp 3805

Drlg.

J. G. McGEHEE

County Stafford State Kans
 Sec. 9 (Blk.) 22 (Sur.) 14W Map No.
 Operator Petroleum Inc.
 Well No. 1 Farm Stroble "B"
 Elev. 1947 Location C N L NW SW

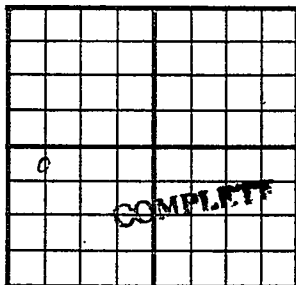

330 Ft. From N Line SW
660 Ft. From W Line Quarter
 1st. Report
 Completion AUG 27 1952
 Remarks Wildcat
 Spudding Date 7-7-52

Drilg. Data Oil well TD 3911

8" @ 243 Heeb. 3336 Tor. 3457

Lans. 3466 DST 3582-3603 open 1 hr.

Rec. 60' ocm 120' hocm 240' free oil

1200# DST 3607-39 open 1 hr. Rec. 30'

socm 30' ocm 0# DST 3646-93

open 1 hr. Rec. 360' gas 45' hocm 45'

vhocm 255' muddy oil 1050# Viola 3763

Simp. 3805 DST 3789-3842 open 1 hr.

Rec. 125' mud 200# Arb. 3861 DST 3863

66 open 1 hr. Rec. 92' vhocm 1225#

DST 3866-79 open 1 hr. Rec. 950' oil

90' hocm 1075# TD 3911 5" @ 3910

16/ 3864-68 16/ 3868-72 2 1/2 boph 100A

P/ 500 bopd Comp. 100 bopd

J. G. McGEHEE