


DX 78-1

Reno KANSAS

Section 9 Township 22 Range 8W

Well No. 1 McKee

Company T. Allan

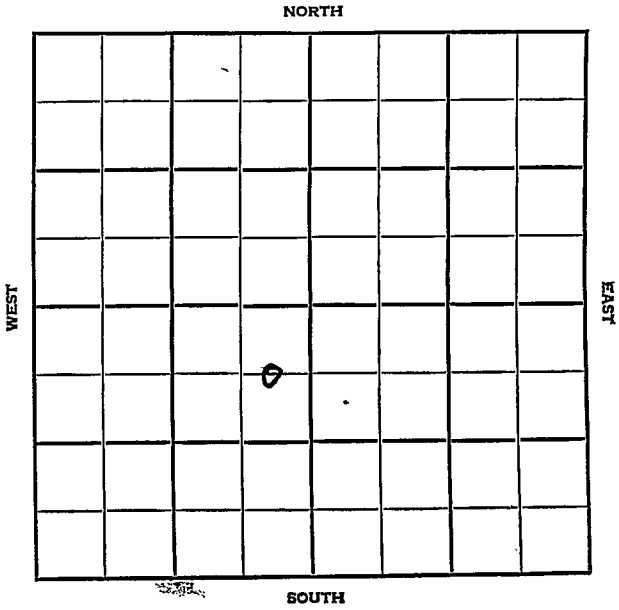

Reno KANSAS

SEC.	TWP.	R.
9	22	8W

WELL NO. _____
 COMPANY 1 McKee FARM

CONTRACTOR T. Allan


Sterling Pool

660 Ft. from N. Line

_____ Ft. from S. Line

330 Ft. from E. Line

_____ Ft. from W. Line

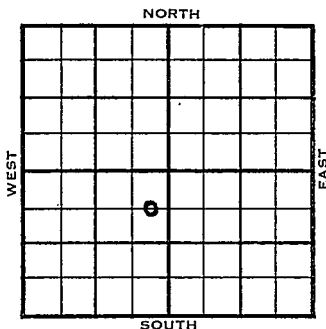

C E/2 NE SW

	ELEVATION	REPORT
1954	1679'	

8/11

Spud 8-4-54
 8" @ 195', WOC

9/15

Spud 8-4-54 - Oil Well
 TD 3487'
 8" @ 195'
 Br line 3028', ^Lans 3054', Miss
 3463'
 TD 3466'
 5" @ 3466'
 DD 3470'
 DD 3487' wtr
 PB 3475' tstg., frac.
 S/16 1/2 bo ;40 bwpd
 Comp. 10 bopd 30 bw

COMPLETED

County Reno State Kansas

Sec. 9 (Blk. 22) (Sur. Rge.) SW Map No.

Operator T. Allan

Well No. 1 Farm McKee

Elev. _____ Location C E $\frac{1}{2}$ NE SW

FIRST REPORT					

660 Ft. From N Line SW

330 Ft. From E Line Quarter

Ist. Report AUG 11 1954

Completion _____

Remarks _____

Spudding Date 8-4-54

Drlg. Data Sterling Pool

8" @ 195 WOC

72

