


DX 78-1

Reno KANSAS

Section 9 Township 22 Range 8W

Well No. 1 Stubbs

Company Tom Allen et al

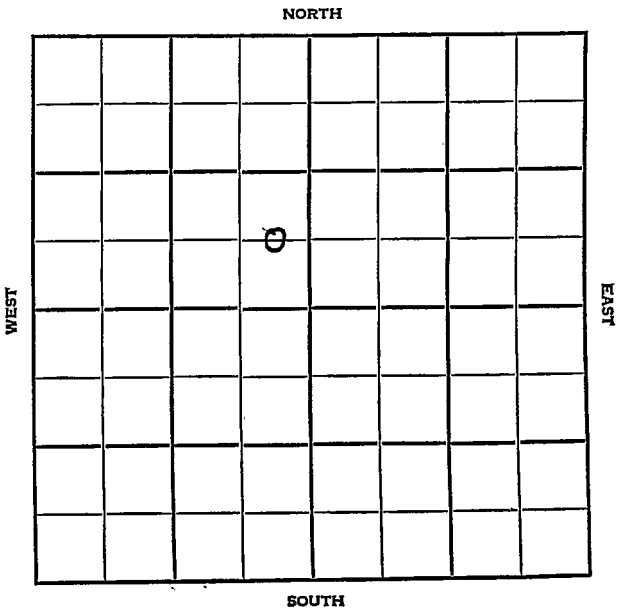

# Reno KANSAS


SEC.	TWP.	R.
9	22	8W
WELL NO.		
1 Stubbs		FARM
COMPANY		
Tom Allen et al		
CONTRACTOR		

\_\_\_\_\_ Ft. from N. Line

660 \_\_\_\_\_ Ft. from S. Line

330 \_\_\_\_\_ Ft. from E. Line

\_\_\_\_\_ Ft. from W. Line

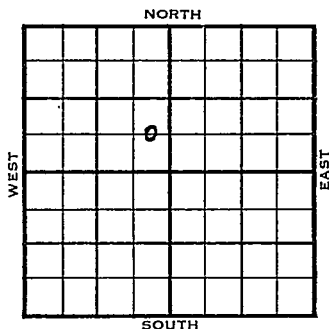

C E  $\frac{1}{2}$  SE NW

	ELEVATION	REPORT
1954	1687'	
6/30	8" @ 200	Drlg. 2515
7/7	Br. li 3021	Lans 3048 Miss 3430
	RTD 3433	5" @ 3433'
7/21	DD 3449'	TD
	Sd-o-frac,	POP
8/25	Spud 6-25-54	Oil well TD 3449
	8" @ 200	Br. lime 3021 Lans 3048
	Miss. 3430	TD 3433 5" @ 3433
	DD 3449	sd-oil-frac. P/2 $\frac{1}{2}$ BOPH
	Comp. 25	BOPD
	<b>COMPLETED</b>	



County Reno State Kansas

Sec. 9 (Blk. 22 (Sur. 8W (Twp.) 22 (Rge.) 8W Map No.

Operator Tom Allen etal.

Well No. 1 Farm Stubbs

Elev. 1687 Location C E $\frac{1}{2}$  SE NW


660 Ft. From S Line NW

330 Ft. From E Line Quarter

1st. Report

Completion AUG 25 1954

Remarks

Spudding Date 6-25-54

Drig. Data Oil well TD 3449

8" @ 200 Br. line 3021 Lans. 3048

Miss. 3430 TD 3433 5" @ 3433 DD 3449

sd-oil-frac P/ 2 $\frac{1}{2}$  boph Comp. 25 bopd

FABEN GILSTRAP