


DX 78-1 Reno

KANSAS

Section 9 Township 22 Range 8W

Well No. #1 Sylvia

Company Tom Allan

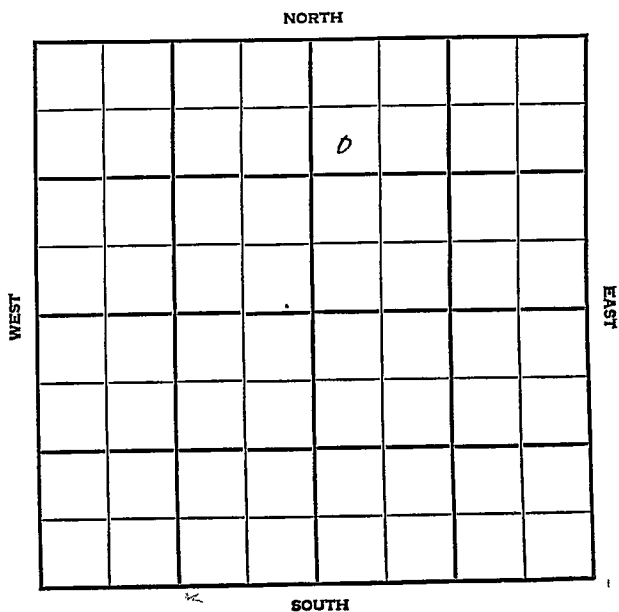

Reno KANSAS

SEC.	TWP.	R.
9	22	8W

WELL NO. 4 Sylvia FARM

COMPANY Tom Allan


CONTRACTOR Co. Tools Sterling Pool

990 Ft. from N. Line

Ft. from S. Line

Ft. from E. Line

330 Ft. from W. Line

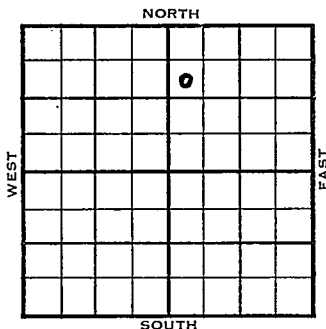

SW NW NE

1954	ELEVATION 1683' RB	REPORT
------	--------------------	--------

10/27 Location
12/1 Spud 11-5-54
Oil Well
TD 3443'
8-5/8" @ 197'
Br. Lime 3011' Lans 3038' Miss 3424'
TD 3426'
5" @ 3426'
DD 3443'
PB 3438'
frac.
Comp 25 bopd.

COMPLETED

FABEN CILSTRAP

FABEN GILSTRAP