


Section 9 Township 22 Range 8 W

Well No. #6 Sylvia

Company Tom Allen

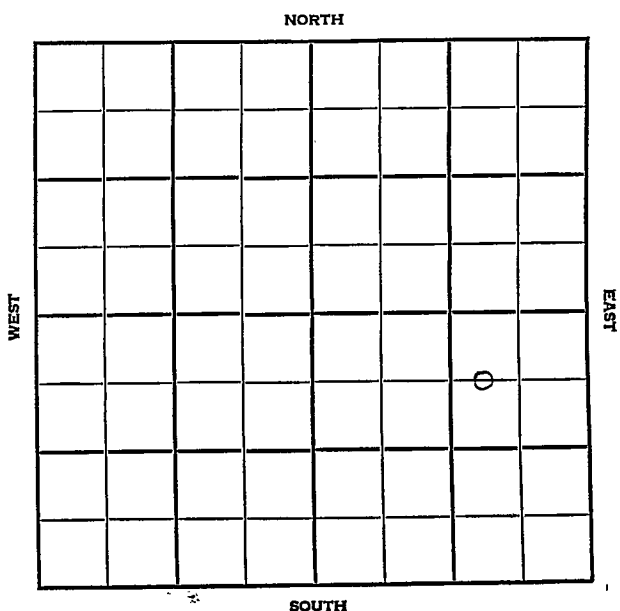

Reno

KANSAS

SEC.	TWP.	R.
9	22	8W

WELL NO.

#6 Sylvia

FARM

COMPANY

Tom Allan

CONTRACTOR

Co. Tools


Sterling

_____ Ft. from N. Line

_____ Ft. from S. Line

_____ Ft. from E. Line

_____ Ft. from W. Line

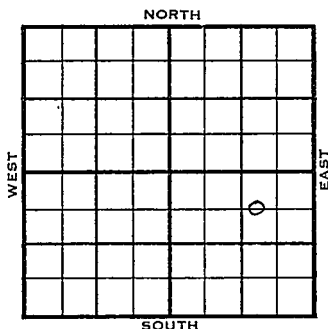C' W $\frac{11}{2}$ NE SE

	ELEVATION	REPORT
1955	1672'	
8/17	Comm 8-12-55 8" @ 208/140	
9-21	5 $\frac{1}{2}$ " @ 3448 Swb 5 boph no wtr. POP Pmp 40 bopd no wtr. Tops: M. 3446 T.D. 3448'	

COMPLETED

County Peno Elev. _____
 Sec. 9 Twp. 22 Rge. 8W
 Company Tom Allan
 Farm Name Sylvia No. 6

TOPS	DEPTH	LOG	DATUM
Anh.			
Tp.			
H.			
Tr.			
Dg.			
BL.			
L.			
K.C.			
B.K.C.			
Ce.			
C.			
M.			
M.			
K.			
Mz.			
Mo.			
V.			
S.			
S.			
A.			
R.			
PE.			
G.			
T.D.			

Loc. in Sec. C 1/2 NE SE

Geol. _____

Contr. _____

Co. tools _____

Pool _____

Sterling _____

AUG 7 1955
 FIRST REPORT
 0

Date Comm. 8-12-55

8" @ 208/11.0

12

County Reno Elev. 1672
 Sec. 9 Twp. 22 Rge. 8W
 Company Tom Allan
 FarmName Sylvia No. 6

TOPS	DEPTH	LOG	DATUM	Loc. in Sec.
Anb.				C W/2 NE SE
TP.				
H.				
Tr.				
Dg.				
BL.				
L.				
K.C.				Geol.
B.K.C.				Contr.
Ce.				Co. tools
C.				Pool
M.	3446		1774	Sterling
M.				
K.				
Mz.				
Mq.				
V.				
S.				
S.				
A.				COMPLETE
R.				
Pe.				
G.				
T.D.	3448			

Date Comm. 8/12/55 SEP 21 1955

8" 208 w/140 5 $\frac{1}{2}$ " 3448 Swb 5 boph no wtr

POP Pmp 40 bopd no wtr

~~3448~~