


Section 9 Township 22 Range 11 WWell No. # 1 EricksonCompany Lee Phillips

NORTH

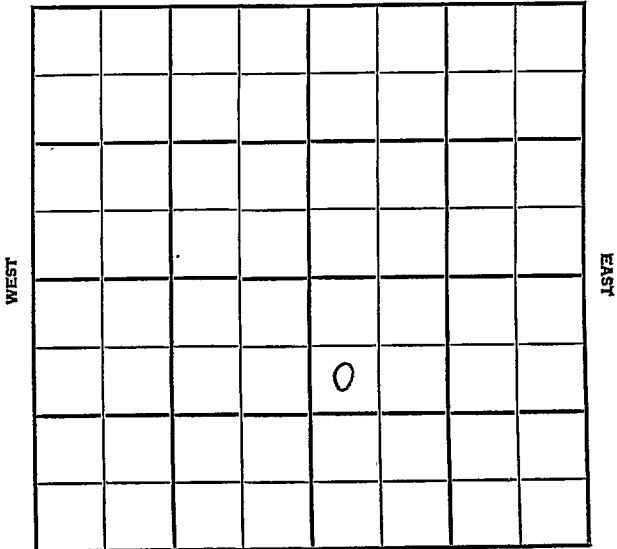

SOUTH

Stafford KANSAS

SEC.	TWP.	R.
9	22	11 W

WELL NO.

1 Erickson

FARM

COMPANY

Lee Phillips

CONTRACTOR

Brock

N. Shepherd Pool


990 Ft. from N. Line

Ft. from S. Line

Ft. from E. Line

330 Ft. from W. Line

SW NW SE

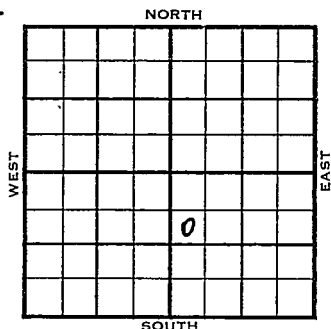

Phillips - DHM

1955	ELEVATION	REPORT
	1763'	

2/16 Cellar & Pits
 3/2 Spud 2-15-55 - D&A
 TD 3592'
 8" @ 275'
 Anhy 465', Heeb. 3011', Br lime 3148',
 ans. 3174'
 DST 3244-52, opn 1 hr., rec. 630'
 SGCSW, 970#
 Cong. 3453'
 DST 3457-80', opn 1 hr., rec. 780'
 gas, 30' VSGCM, 442#
 Simp. sh 3514', Re-Arb. 3544, Arb.
 3560'
 DST 3536-61', opn 1 hr., rec. 30' mud,
 90#
 TD 3592'
 D&A

ABANDONED

County Stafford State KansasSec. 9 (Blk.
Twp.) 22 (Sur.
Rge.) 11W Map No.Operator Lee PhillipsWell No. 1 Farm EricksenElev. Location SW NW SE

990 Ft. From N Line SE330 Ft. From W Line QuarterIst. Report FEB 1 6 1955


Completion

Remarks Phillips - DHMBrock - Contr.

Spudding Date

Drlg. Data N. Shepherd PoolCellar & pits

FABEN GILSTRAP

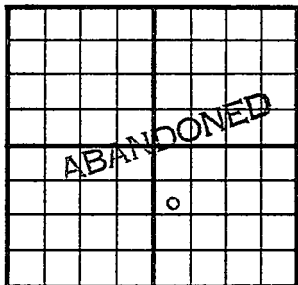County Stafford State KansasSec. 9 (Blk. Twp.) 22 (Sur. Rge.) 11W Map No.Operator Lee PhillipsWell No. 1 Farm EricksenElev. 1763 Location SW NW SE990Ft. From N Line SE330Ft. From W Line Quarter

1st. Report

Completion MAR 2 1955Remarks N. Shepherd PoolBrock - Contr.Spudding Date 2-15-55Drlg. Data D & A TD 35928" @ 275 Anhy 465 Heeb. 3011Br. lime 3148 Lens. 3174 DST 3244-52open 1 hr. Rec. 630' sgcsw 970#Cong. 3453 DST 3457-80 open 1 hr.Rec. 780' gas 30' vsgcm 442#Simp. sh. 3514 ReArb. 3544 Arb. 3560DST 3536-61 open 1 hr. Rec. 30' mud90# TD 3592D & A

FABEN GILSTRAP