

Section 9 Township 22 Range 12W

Well No. 1 Denker

Company Harry Gore

Max

NORTH

						0	

WEST

EAST

SOUTH

Sec. 9 Twp. 22 R. 12W

Well No. #1 Denker Farm _____
Harry Gore Company _____

Max Pool

_____ Ft. from N. Line

990'


_____ Ft. from S. Line

990'

_____ Ft. from E. Line

_____ Ft. from W. Line

~~SW~~ ^{NW} SE SE

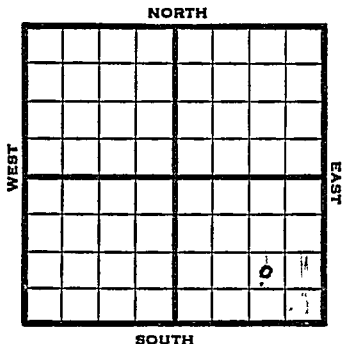

1949 Elev. 1865' REPORT

8/31 Location

9/7 8" @ 338'

Drlg. 2000'

9/14 Lansing 3304'

Simpson 3612'

Drlg 3638'

9/21 Arbuckle 3669'

5" @ 3669'

TD 3672'

3335' oil in 6 hrs.

10/5 Arb. 3669'

5" @ 3669'

Echo Pot. 1618 oil

Gr. 39.0

TD 3672'

COMPLETED

Map No. _____ Sec. 9 Twp. 22 R. 12W

Well No. 1 Denker

Harvy Gore Company

Contractor

C W L SE SE

**FIRST REPORT
SECTION PLAT**

_____ Ft. from N. Line

990 Ft. from S. Line

990 Ft. from E. Line

_____ Ft. from W. Line

			o

Stafford County

Location X

Rig up _____

Drilling and Remarks: _____

RECORD

Cased _____ in., _____ ft.

Sand _____

Gas _____

Oil _____

Total Depth _____

PRODUCTION

1st 24 hrs. Nat. _____

1st 24 hrs. after shot _____

Gas _____ Cu. Ft.

Dry Hole _____

Abandoned _____

Date

AUG 31 1949 19

S. J. LEWIS Scout

Kansas

Map No. _____ Sec. 9 Twp. 22 R. 12W

Well No. 1 Denker

Harry Gore _____ Company

COMPLETE

Contractor

C W L S E S E


E. I. 1965
SECTION PLAT

_____ Ft. from N. Line

990 Ft. from S. Line

990 Ft. from E. Line

_____ Ft. from W. Line

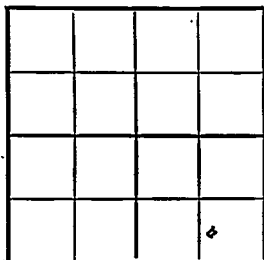

Stafford County

Location _____

Rig up _____

Drilling and Remarks:

*Or X3669**5" @ 3669**Echord 16 Tool**39° E*

RECORD

Cased _____ in. _____ ft.

Sand _____

Gas _____

Oil _____

Total Depth *8672*

PRODUCTION

1st 24 hrs. Nat. _____

1st 24 hrs. after shot _____

Gas _____ Cu. Ft.

Dry Hole _____

Abandoned _____

Date

OCT 5 1949 19

S. J. LEWIS Scout