

Section 9 Township 22 Range 12W

Well No. #3 Denker

Company Harry Gore

Max Pool

NORTH

WEST

EAST

SOUTH

2

Sec. 9 Twp. 22 R. 12W

Well No. #3 Denker Farm

Harry Gore Company

Max Pool

_____ Ft. from N. Line

660'


_____ Ft. from S. Line

_____ Ft. from E. Line

990'

_____ Ft. from W. Line

C E L SW SE

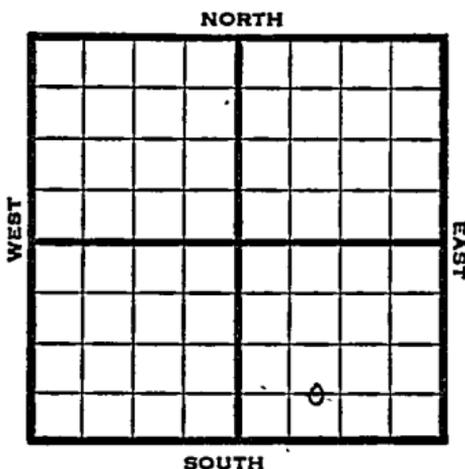

1949

REPORT

12/14

Location

12/21

8" @ 340'

Drlg 1950'

12/28

Lansing 3307'

Drlg 3357'

1950

2/15

TD 3682'

8" @ 340'

5 1/2" set 3679'

Lans 3307'

Arb. 3677'

215 BOPD

Comp

COMPLETED

Kansas

Max Pool

Map No. _____ Sec. 9 Twp. 22 R. 12WWell No. 3 Denker

_____ Harry Gore _____ Company

Contractor

C E L SW SE

FIRST REPORT
SECTION PLAT

_____ Ft. from N. Line

660 Ft. from S. Line

_____ Ft. from E. Line

990 Ft. from W. Line

Stafford County

Location X

Rig up _____

Drilling and Remarks:

RECORD

Cased _____ in., _____ ft.

Sand _____

Gas _____

Oil _____

Total Depth _____

PRODUCTION

1st 24 hrs. Nat. _____

1st 24 hrs. after shot _____

Gas _____ Cu. Ft.

Dry Hole _____

Abandoned _____

Date

DEC 14 1949 19S. J. LEWIS Scout

Map No. _____ Sec. 9 Twp. 22 R. 12W

Well No. 3 Denker

Harry Gore Company

Contractor

C E L SW SE

SECTION PLAT

_____ Ft. from N. Line

660 Ft. from S. Line

_____ Ft. from E. Line

990 Ft. from W. Line

COMPLETE			
		6	

Stafford County

Location _____

Rig up _____

Drilling and Remarks:

8" @ 3140
5 1/2" @ 3679
Lans 3307
and 3677
215 BOPD

RECORD

Cased _____ in., _____ ft.

Sand _____

Gas _____

Oil _____

Total Depth 3682

PRODUCTION

1st 24 hrs. Nat. _____

1st 24 hrs. after shot _____

Gas _____ Cu. Ft.

Dry Hole _____

Abandoned _____

Date

FEB 15 1950

J. E. TYRA

19 _____

Scout