

Section 9 Township 22 Range 12W

Well No. #1 Teichman

Company Harms & Knight

NORTH

	0						
WEST							EAST

SOUTH

Stafford

Sec. 9 Twp. 22 R. 12^W

Well No. #1 Teichman Farm

Harms & Knight Company

Contractor


330 Ft. from N. Line

_____ Ft. from S. Line

_____ Ft. from E. Line

330 Ft. from W. Line

NW NW NW

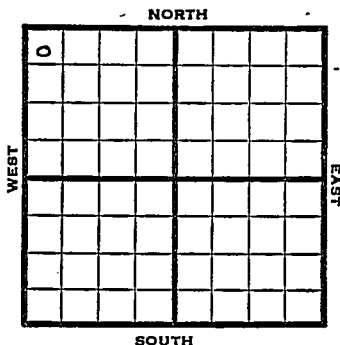

1952

Elev. 1866' REPORT

1/23

Spud 1-19-52
8" @ 307'

Drlg. 1780'

2/6

Drlg. 2963'

2/13

Spud 1-19-52

D&A TD 3707
8" @ 307

Heeb. 3185 Br lime 3320

Lans. 3333 Viola 3613

DST 3624-37 opn 1 hr.

Rec. 30' socm TD 3707

D&A

ABANDONED


County **Stafford** State **Kansas**

Sec. **9** (Blk. Twp.) **22** (Sur. Rge.) **12W** Map No.

Operator **Harms & Knight**

Well No. **1** Farm **Teichman**

Elev. **1866** Location **NW NW NW**

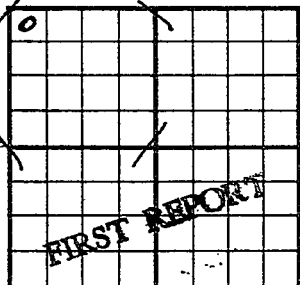

330 Ft. From **N** Line **NW**

330 Ft. From **W** Line **Quarter**

Ist. Report **JAN 23 1952**

Completion

Remarks

Spudding Date **1-19-52**

Drlg. Data **Drauch**

8" @ 307 Drlg. 1780

J. E. TYRA

County Stafford State Kansas

Sec. 9 (Blk. 22) (Sur. 12W) Map No.

Operator Harms & Knight

Well No. 1 Farm Teichman

Elev. 1866 Location NW NW NW

0					

330 Ft. From N Line NW

330 Ft. From W Line Quarter

1st. Report

Completion FEB 13 1952

Remarks Drauch Pool

Spudding Date 1-19-52

Drig. Data D & A TD 3707

8" @ 307 Heeb. 3185 Br. lime 3320

Lans. 3333 Viola 3613 DST 3624-37

open 1 hr. Rec. 30' socm TD 3707

D & A

J. G. McGEHEE