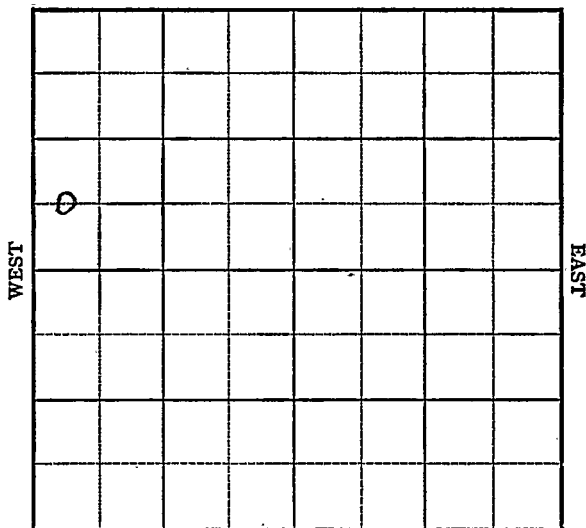


KANSAS

Stafford

Section 9 Township 22 Range 12WWell No. 1 TeuchmannCompany Barnett DrlgBrock
NORTH

KANSAS

Stafford

Sec. 9 Twp. 22 R. 12W ✓

Well No. #1. Teuchmann Farm

Barnett Drlg. Company

Brock Pool

 Ft. from N. Line

660'


 Ft. from S. Line

 Ft. from E. Line

330'

 Ft. from W. Line

C W L SW NW

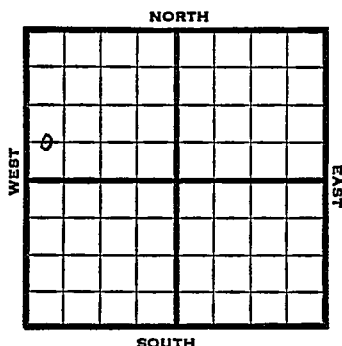

1949

Elev 1873'

R E P O R T

2/16

RUR

2/23

8" @ 278'

Drlg. 1900'

3/2

Drlg. 3374'

3/9

TD 3785'

Lans. 3334'

Viola 3588'

Simp 3634'

Arb. 3693'

Aband.

ABANDONED

Map No. _____ Sec. 9 Twp. 22 R. 12W

Well No. 1 Teuchmann

Barnett Drlg. Company

FIRST REPORT Contractor

C W L SW NW

SECTION PLAT

_____ Ft. from N. Line

660 Ft. from S. Line

_____ Ft. from E. Line

330 Ft. from W. Line

o			

Stafford County

Location _____

Rig up _____

Drilling and Remarks:

R U R

RECORD

Cased _____ in., _____ ft.

Sand _____

Gas _____

Oil _____

Total Depth _____

PRODUCTION

1st 24 hrs. Nat. _____

1st 24 hrs. after shot _____

Gas _____ Cu. Ft.

Dry Hole _____

Abandoned _____

Date

FEB 16 1949 19

S. J. LEWIS Scout

Kansas


Map No. K46 Sec. 9 Twp. 22 R. 12WWell No. 1 TeichmannBarnett Drlg.

Company

ABANDONED

Contractor

C W L SW NW

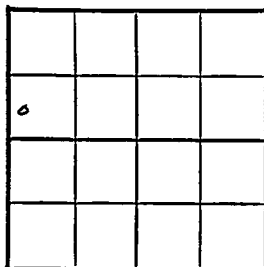E1,183
SECTION PLAT Ft. from N. Line660 Ft. from S. Line Ft. from E. Line330 Ft. from W. Line

Stafford County

Location Rig up

Drilling and Remarks:

None 3334
W 3338
Simple 3634
Ch 8 3693

RECORD

Cased in., ft.Sand Gas Oil Total Depth 3285

PRODUCTION

1st 24 hrs. Nat. 1st 24 hrs. after shot Gas Cu. Ft.Dry Hole Abandoned

Date

MAR 9 1949 19

S. J. LEWIS

Scout