

O.W.W.O.

Finney KANSAS

Section 9 Township 22 Range 33 WWell No. # 1 Graves ^{Unit} "B"Company D. R. Lauck *Texas Company*

NORTH

WEST

EAST

SOUTH

O.W.W.O.

Finney

KANSAS


SEC.	TWP.	R.
9	22	33 W ✓
WELL NO.		
# 1 Graves ^{unit} #B		
COMPANY		FARM
D. R. Lauck		Texas Company
CONTRACTOR		
Lauck		

_____ Ft. from N. Line

330 _____ Ft. from S. Line

330 _____ Ft. from E. Line

_____ Ft. from W. Line

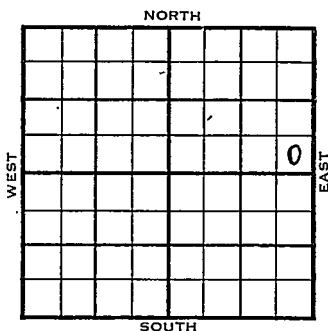

SE SE NE

	ELEVATION	REPORT
1953	2891'	
12/30	MIR	
1954		
1/6	8" @ 240' w/140 sks	
	Drlg 1550'	
1/13	Heeb 3803', Lans 3846'	
	Drlg 4188'	
1/20	Spud 12-31-53	
	D&A	
	TD 4911'	
	8" @ 240'	
	Heeb 3803', Lans 3846', B KC 4333',	
	Marm. 4353', Cherokee 4473', Miss	
	4748'	
	TD 4911'	
	D&A	
		ABANDONED
1956		
	O.W.W.O.	
7-11	CO to 2736	
	5" @ 2715 w/1000	
	CO to 2654, 20/2611-16, 250 A, frac	
	2000 A, tstg.	
	TD 4911'	

OVER

1956

8-1

Tst 64 mcf g

tst 119 mcf g / 11 GW,

PB 2600 16/2556-70, 40/2580-90,
16/2556-70

PB 3609

tst 3.38 mcf / 144 GWPH,

tst 3.186 mcf

PB 2548 24/2530-36

CO 2609


tst 2.716 mcf / 138 gwph,

SI 72-20; 5.261 MCF; CP 390#.

Log topHoll. 2529'; Herr. 2558'; Kri. 2579';

TD 4911'

COMPLETED

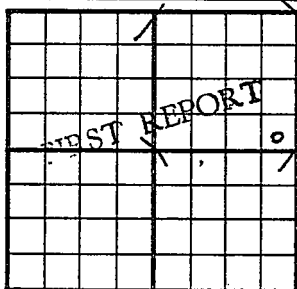County Finney State KansasSec. 9 (Blk. Twp.) 22 (Sur. Rge.) 3 3W Map No.Operator D. R. LauckWell No. 1 Farm Graves "B"Elev. _____ Location SE SE NE330 Ft. From S Line NE330 Ft. From E Line Quarter1st. Report DEC 30 1953

Completion _____

Remarks _____

Lauck - Contr.

Spudding Date _____

Drilg. Data _____

M I R


J. G. McGEHEE

County Finney State Kansas
 Sec. 9 (Blk. Twp.) 22 (Sur. Rge.) 33W Map No.

Operator D. R. Lauck

Well No. 1 Farm Graves "B"

Elev. 2891 Location SE SE NE

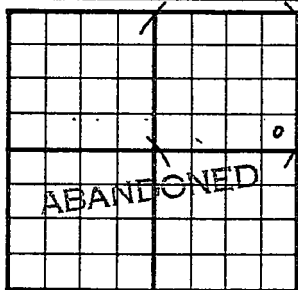

330 Ft. From S Line NE

330 Ft. From E Line Quarter

1st. Report

Completion JAN 20 1954

Remarks

Lauck - Contr.

Spudding Date 12-31-53

Drlg. Data D & A TD 4911

8" @ 240 Heeb. 3803 Lans. 3846

B KC 4333 Marm. 4353 Cherokee 4473

Miss. 4748 TD 4911

D & A

FORM 513 SUNRAY

County Finney Elev. _____
 Sec. 9 Twp. 22 Rge. 33W
 Company Texas Company (was D. R. Lauck)
 Farm Name Graves Unit No. 1

[illegible]

Date Comm.

CO to 2736 5" @ 2715/1000 CO to 2654
20/ 2611-16 250 A frac 2000 A
tstg.

1110 C 7 7078


County Finney Elev. 2891 DF
 Sec. 9 Twp. 22 Rge. 33N

TOPS	DEPTH	LOG	DATUM	Loc. in Sec.
Anh. <u>Hall</u>		<u>2529</u>		<u>5' 5' 12</u>
Tr. <u>Herr</u>		<u>2556</u>		
H. <u>Kri</u>		<u>2579</u>		
Tr.				
Dg.				
Bl.				
L.				
K.C.				Geol.
B.K.C.				Contr.
Ce.				
C.				
M.				
M.				Pool
K.				<u>Huron Gas</u>
Mz.				
Ma.				
V.				
S.				
S.				
A.				
R.				
PE.				
G.				
TD.	<u>1911</u>			

COMPLETE

Date Comm. AUG 1 1956

50 to 2726 5" C 2715/1000 30 to 2654
20/ 2611-16 250 A frac 2000 A
tstg. JUL 18 '56 f5t 64 MCF G / 2
f5t 119 MCF + 11 GW PB 2600
16/2556-70 40/2580-90 16/2556
-70 CO TO 2622 90 S. 261 MCF
+ 450 GWPH PB 2609 f5t 3.38
MCF + 144 GWPH JUL 25 '56 f5t 3.186
MCF PB 2548 24/2530-36

FRAC CO 2609 TST 2.716

MCF + 138.6 WPH, S.I. AUG 1 '66

72.20 5.261 MCF

CP 390

7-11-66

11-11-66