


Section 9 Township 22 Range 34W

Well No. #1 Noomis

Company Warren Petroleum

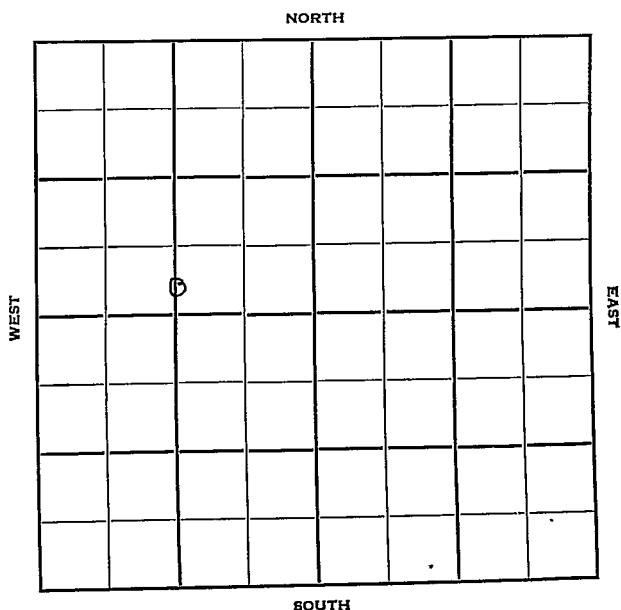

Finney

KANSAS

Sec. 9 Twp. 22 R. 34 W ✓

Well No. # 1 Noonis Farm

Warren Petroleum Company

Contractor


Ft. from N. Line

330 Ft. from S. Line

Ft. from E. Line

1320 Ft. from W. Line

C S L S $\frac{1}{2}$ NW

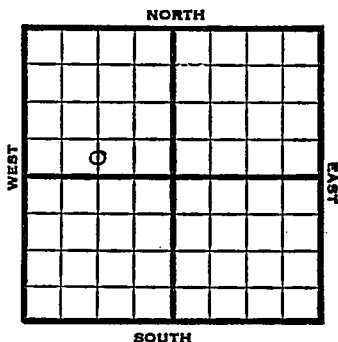

1951

Elev. 2967' REPORT

8/22

10-3/4" @ 198' WOC

10/3

Gas well TD 2636' 10-3/4" @ 198
7" @ 2537 TD 2636' Her. 2566'
Win. 2614' 16,000 A
Comp. 17,000,000 gas

COMPLETED

J. E. TYRRELL

County Finney State Kansas

Sec. 9 (Blk. Twp.) 22 (Sur. Rge.) 34W Map No.

Operator Warren Petroleum

Well No. 1 Farm Noomis

Elev. 2967 Location C S L S $\frac{1}{2}$ NW

330 Ft. From S Line NW

1320 Ft. From W Line Quarter

1st. Report _____

Completion OCT 3 1951

Remarks	Hugoton Pool
---------	--------------

Spudding Date

Drig. Data Gas well TD 2636

10 3/4" @ 198 7" @ 2537 TD 2636

Her. 2566 Win. 2614 16000 A .

Comp. 17,000,000 gas

J. E. TYRA