


Section 1 Township 23 Range 2-W

Well Number 2 Workention "B"

Company Palmer Oil

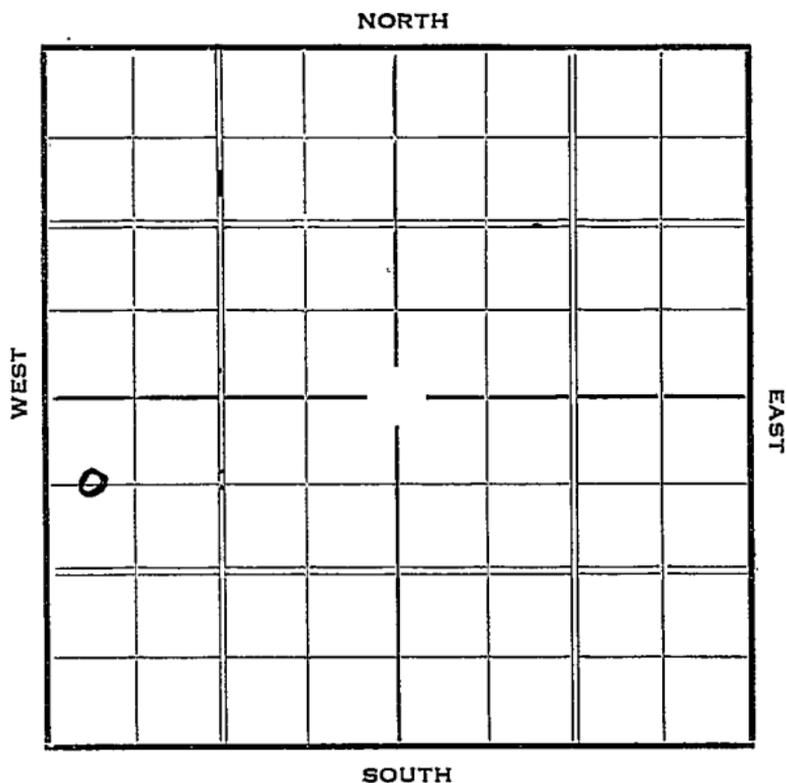

Sec. 1 Twp. 23 R. 2-W

Well No. #2 Workention "B" Farm

Palmer Oil Company


660 Ft. from N. Line

\_\_\_\_\_ Ft. from S. Line

\_\_\_\_\_ Ft. from E. Line

330 Ft. from W. Line

Elev. 1456

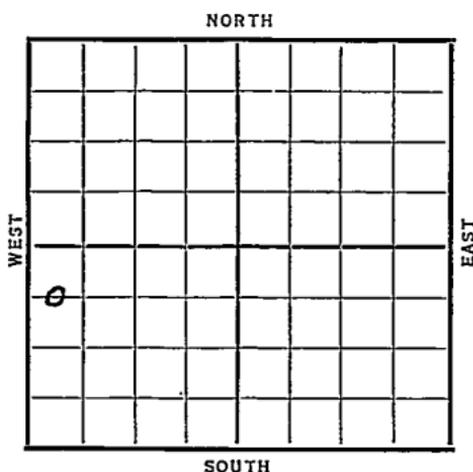

Date	REPORT
1936	
11/25	12" @ 145'. Drlg. 600'.
12/3	Drlg. 2795'.
12/10	Chat 2967'. 8" @ 2974'.
	T. D. 2978'. RUST.
12/17	T. D. 3002'.
12/24	Water. Shut down.
12/29	" " "
1937	
1/7	6" @ 3255'. Drlg.
1/14	Hunton 3292'. Drlg. 3374'.
1/21	6" @ 3404'. Show oil 3415-30'
	Drlg. 3455'.
1/28	Sil. 3496'. Hole full
	water 3513'. T. D. 3527'.
	Shut down.
2/4	Drlg. 3663'.
2/11	T.D. 3860 S.D.
2/17	Sil. 3496'.
	T. D. 3527'.
	H.F.W. 3513'.
	<b>ABANDONED</b>

Map No. 39 Sec. 1 Twp. 23 R. 2W

Well No. 2. Open to Top B

Palmer Oil Company

Contractor

**SECTION PLAT**

660 Ft. from N. Line

\_\_\_\_\_ Ft. from S. Line

\_\_\_\_\_ Ft. from E. Line

320 Ft. from W. Line

0			

**REPORT**

Location \_\_\_\_\_

Rig up \_\_\_\_\_

Drilling and Remarks:

12" @ 145  
D 2 19 600

**RECORD**

Cased \_\_\_\_\_ in., \_\_\_\_\_ ft.

Sand \_\_\_\_\_

Gas \_\_\_\_\_

Oil \_\_\_\_\_

Total Depth \_\_\_\_\_

**PRODUCTION**

1st 24 hrs. Nat. \_\_\_\_\_

1st 24 hrs. after shot \_\_\_\_\_

Gas \_\_\_\_\_ Cu. Ft.

Dry Hole \_\_\_\_\_

Abandoned \_\_\_\_\_

Date

**NOV 25 1936** 19

**S. J. LEWIS** Scout

**KANSAS**

Map No. Harvey 39 Sec. 1 Twp. 23 R. 2W

Well No. 2 Work on tin & "B"

Palmer Oil Company

Contractor

**SECTION PLAT**

660 Ft. from N. Line

\_\_\_\_\_ Ft. from S. Line

\_\_\_\_\_ Ft. from E. Line

330 Ft. from W. Line

0			

**ABANDONED**

Location \_\_\_\_\_

Rig up \_\_\_\_\_

Drilling and Remarks:

Sil 3496.

H.F.W 3513

**RECORD**

Cased \_\_\_\_\_ in., \_\_\_\_\_ ft.

Sand \_\_\_\_\_

Gas \_\_\_\_\_

Oil \_\_\_\_\_

Total Depth 3527

**PRODUCTION**

1st 24 hrs. Nat. \_\_\_\_\_

1st 24 hrs. after shot \_\_\_\_\_

Gas \_\_\_\_\_ Cu. Ft.

Dry Hole

Abandoned

Date

FEB 17 1937 19

S. J. LEWIS Scout