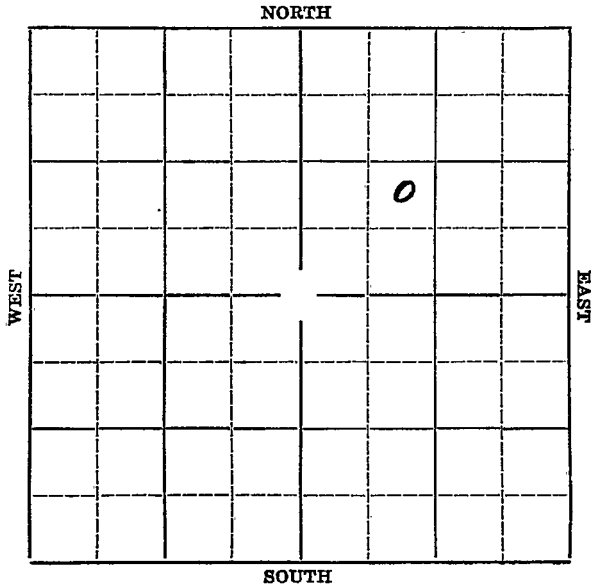


Section 1 Township 23 Range 4-WWell Number #1-GoeringCompany Palmer

Sec. 1 Twp. 23 R. 4W

Well No. #1 Goering Farm


Palmer _____ Company

Ft. from N. Line

990' Ft. from S. Line

Ft. from E. Line

990' Ft. from W. Line

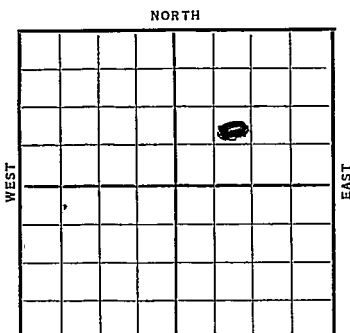

(Under new ownership. Old wells abandon^{SOUTH}

Date 1956 Elev. 1461 REPORT ed)

8/19	Rig.
------	------

8/27 -- 9/3 -- 9/10 -- 9/18 -- 9/24 --

10/1 12" @ 298'. Drlg. 506'.

10/8 Drlg. 1722'.

10/15 Drlg. 2850'.

10/22	Chat 3254'. 7" @ 3265'. Drlg.
	3267'.

10/28/36-Chat 3254'.

T.D. 3347'.

Hole full of water at 3327'.

Dry and abandoned.

ABANDONED

KANSAS

Map No. 40 Sec. 1 Twp. 23 R. 4WWell No. 1 GoringPalmer Company

Contractor

SECTION PLAT

 Ft. from N. Line990 Ft. from S. Line Ft. from E. Line990 Ft. from W. Line

FIRST REPORT

Location Rig up

Drilling and Remarks:

*Rig
under new
ownership
Old well is
abandoned.*

RECORD

Cased in., ft.Sand Gas Oil Total Depth

PRODUCTION

1st 24 hrs. Nat. 1st 24 hrs. after shot Gas Cu. Ft.Dry Hole Abandoned

Date


8/19/36 1936 B. Lewis Scout

KANSAS

Map No. 40 Sec. 1 Twp. 23 R. 4WWell No. 1 GoeringPalmer Company

Contractor

SECTION PLAT

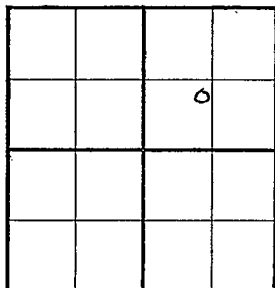 Ft. from N. Line990 Ft. from S. Line Ft. from E. Line990 Ft. from W. Line

ABANDONED

Location Rig up

Drilling and Remarks:

Cha 8 3254NFW 3327IT & H

RECORD

Cased in., ft.Sand Gas Oil Total Depth 3347

PRODUCTION

1st 24 hrs. Nat. 1st 24 hrs. after shot Gas Cu. Ft.Dry Hole Abandoned

Date

OCT 28 1936 19

S. J. LEWIS

Scout