


Map No. KANSAS Sec. 19 Twp. 23 R. 4W

Well No. 1- Looking Farm Derby Oil & Refining Company

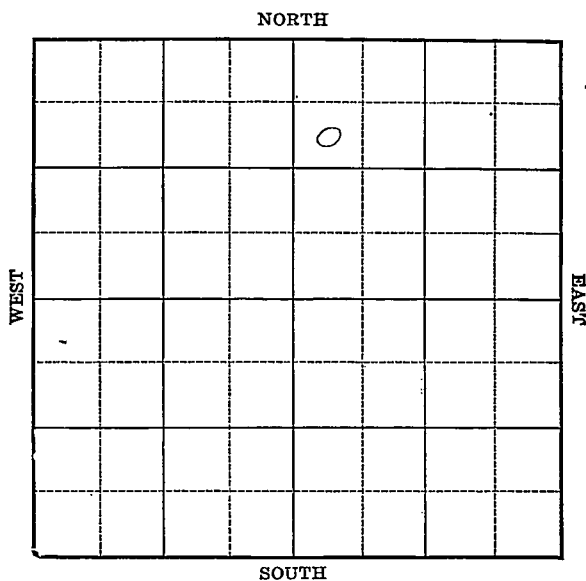

Location _____
Drilling Remarks _____

Rig Up _____
Drilling Remarks _____

RECORD

Cased _____ in. _____ ft.
Sand _____
Gas _____
Oil _____
Total Depth _____

PRODUCTION

1st 24 hrs. Nat. _____
1st 24 hrs. after shot _____
Gas _____ cu. ft.
Dry Hole _____
Abandoned _____

Map No. KANSAS Sec. 1 Twp. 23^s R. 4^w

Well No. 1 - Goring Farm

Derby Oil & Refining Company


990 Ft. from N. Line

_____ Ft. from S. Line

_____ Ft. from E. Line

330 Ft. from W. Line

1931 EL. 1458

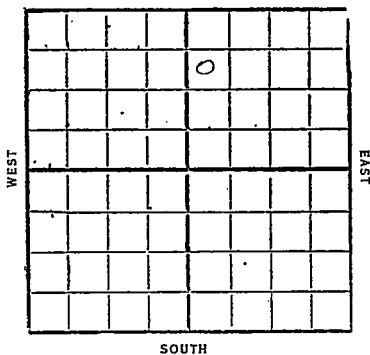

Date

REPORT

2/11	Loc
2/18	
2/25	
3/4	
3/11	Drilg water well
3/18	Bldg rig
3/25	Run up
4/11	15" - 268'
4/18	Drilg 2510'
4/15	Top Chat 3245'
	Cem 8"
	S.D. 3257
4/22	show oil 3326-36
	Bldg
4/29	Top Chat 3245'
	Oil 3336-51
	T.D. 3351
	swab 85 bbl 22 hrs
5/6	Base line 3530'
	Top Hunton 3626
	small sho oil & water

5/13- Viola ~~3737~~ 48'
T.D. 3748' Rust

5/20- Top Viola 3733 (S.L.M.)
HFw 3744-52
Sand 3755-58'

U/R 6"
5/27- Wilcox 3762-90
drlg 3802.

6/3- Isq ~~3890~~

6/10- T.D. 3870'
P.B. 3360

Pay 3326-36
Made 87½ bbl oil
and 47½ bbls water
in 24 hrs

6/17- Mkg 47 bbl per day

6/24 (P.B. 3360)

Made 87½ bbl oil and
12½ bbl water, 24 hr

7/1 - Chat 3326-36 show
Top Viola 3733
" Wilcox 3762-90
T.D. 3870
P.B. 3360 (Chat)


Made 87½ bbl oil
and 12½ " water
Comp.

Map No. KANSAS Sec. 1 Twp. 22 R. 4 W

Well No. 48 1 Goering

Terby Oil & Reserve Oil Company
Contractor

SECTION PLAT

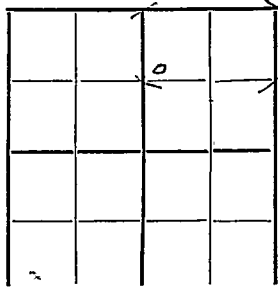

990 Ft. from N. Line

..... Ft. from S. Line

..... Ft. from E. Line

830 Ft. from W. Line

FIRST REPORTS

Location ✓

Rig up

Drilling and Remarks:

RECORD

Cased.....in.,ft.

Sand.....

Gas.....

Oil.....

Total Depth.....

PRODUCTION

1st 24 hrs. Nat.....

1st 24 hrs. after shot.....

Gas.....Cu. Ft.

Dry Hole.....

Abandoned.....

Date

FEB 11 1931
192

S. J. LEWIS Scout

Map No. KANSAS Sec. 1 Twp. 23 R. 4W

Well No. 1 Goering

Terry Oil & Refining Company

Contractor

SECTION PLAT

990 Ft. from N. Line

Ft. from S. Line

Ft. from E. Line

330 Ft. from W. Line

		0	

CORRECTION

Location ✓

Rig up

Drilling and Remarks:

Reputed
1-22-4W

RECORD

Cased in., ft.

Sand

Gas

Oil

Total Depth

PRODUCTION

1st 24 hrs. Nat.

1st 24 hrs. after shot

Gas Cu. Ft.

Dry Hole

Abandoned

Date

MAR 4 1931 192 S. J. LEWIS Scout

Reno

40 KANSAS Map No. Sec. 1 Twp. 73 R. 4 W

Well No. 1 Goering

Derby Oil & Reserve Company

Contractor

COMPLETE

SECTION PLAT

		0	

990 Ft. from N. Line

Ft. from S. Line

Ft. from E. Line

330 Ft. from W. Line

Location

Rig up

Drilling and Remarks:

Top Viola 3733'

Mud Cox 3762-90'

PB to 3360'

87 1/2 Bls on

12 1/2 " water

RECORD

Cased in, ft.

Sand Chat About 3376-36

Gas

Oil

Total Depth 3870

PRODUCTION

1st 24 hrs. Nat.

1st 24 hrs. after shot

Gas Cu. Ft.

Dry Hole

Abandoned

Date

JUL 1 1931

192

CHAS. L. SHERWOOD

Scout