


Map No. KANSAS Sec. 1 Twp. 23 R. 4^W

Well No. 1-Bohring Farm Study & Turner Company

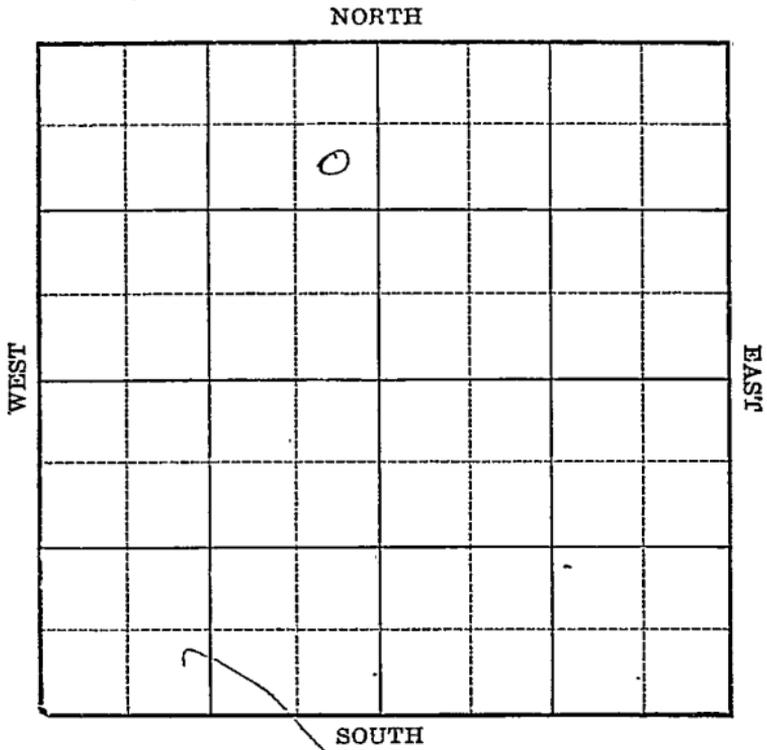

3

Location _____
Drilling Remarks _____

Rig Up _____
Drilling Remarks _____

RECORD

Cased _____ in. _____ ft.

Sand _____

Gas _____

Oil _____

Total Depth _____

PRODUCTION

1st 24 hrs. Nat. _____

1st 24 hrs. after shot _____

Gas _____ cu. ft.

Dry Hole _____


Abandoned _____

Map No. KANSAS Sec. 19 Twp. 23 R. 4^w

Well No. 1 - Boering Farm

Study-Turner Dural Company

NORTH

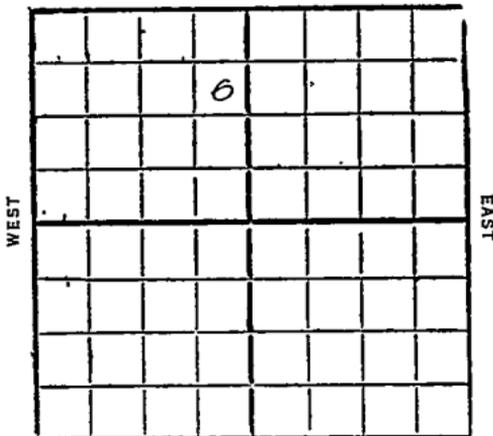

990 Ft. from N. Line

_____ Ft. from S. Line

330 Ft. from E. Line

1931 Ft. from W. Line

SOUTH

Date REPORT

Date	REPORT
3/18	Log
3/25	Log
4/11	Bldg. rig
4/18	
4/15	Run up
4/22	Spdg.
4/29	15" - 2492
	drlg 528'
5/6	" 1158'
5/13	Cave cemented 1710'
5/20	10" - 1896'
5/27	10" - 1935'
	drlg 2130'
6/3	" 2278'
6/10	10" - 2278'
	drlg 2503'
6/17	8" - 2510'
	drlg 2729'
6/24	" 2868'
7/1	6" - 2924'
	drlg 2940'
	(over)

- 7/8- Drlg. 3167'
Show gas 3010'
6" - 2950
- 7/15- 6"-3240
Drlg 3241
- 7/22- Top Chat 3241
Rng 6" csq
- 7/29- First Gas at 3290
TD 3348
flow 47 bbls 2 hrs
" 116 " 41 hrs
with 18 bbl water
- 8/5- TD. 3348
Rng tubing
- 8/12- Chat 3241-3348
TD. 3348
Made 75 bbl oil
and 2 " water
Comp.

Map No. KANSAS Sec. 1 Twp. 23 R. 4 W
 Well No. 40 Goering

Stucky & Turner & Co. Company
 Contractor

SECTION PLAT

990 Ft. from N. Line
 Ft. from S. Line
330 Ft. from E. Line
 Ft. from W. Line

	6		

FIRST REPORTS

Location

Rig up

Drilling and Remarks:

RECORD

Cased..... in., ft.

Sand

Gas

Oil

Total Depth.....

PRODUCTION

1st 24 hrs. Nat.....

1st 24 hrs. after shot.....

Gas..... Cu. Ft.

Dry Hole.....

Abandoned.....

Date

MAR 18 1931

S. J. LEWIS

Scout

Pano

Map No. **KANSAS** Sec. *1* Twp. *73* R. *4* W

Well No. *1* *Geering*

Stacy & Turner & Co Company

Contractor

COMPLETE

SECTION PLAT

990 Ft. from N. Line
 Ft. from S. Line
330 Ft. from E. Line
 Ft. from W. Line

	0		

Location.....

Rig up.....

Drilling and Remarks:

75 Bls Oil
2 " Water

RECORD :

Cased in., ft.
 Sand *@ hat 3241-3348*
 Gas.....
 Oil.....
 Total Depth *3348*

PRODUCTION

1st 24 hrs. Nat.
 1st 24 hrs. after shot.....
 Gas..... Cu. Ft.
 Dry Hole.....
 Abandoned.....

Date

AUG 12 1931

CHAS. L. SHERWOOD
 192 Scout