



Map No. \_\_\_\_\_ Sec. 1 Twp. 23 R. 4<sup>W</sup>


Well No. 1 Goering Farm  
Manning Terry et al Company

330' Ft. from N. Line

\_\_\_\_\_ Ft. from S. Line

\_\_\_\_\_ Ft. from E. Line

330' Ft. from W. Line

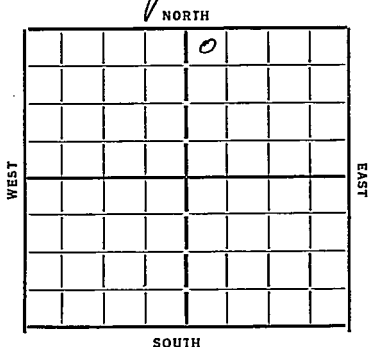

Date 7/23

REPORT

5/3 Cellar & Pond  
5/10 Rigging up Rotary  
5/17 Cement 12" 327-W.O.C.  
5/24 Dlg 2217  
6/1 Dlg 2865  
6/18 Top chat 3223 8" 3228 R., S., T.  
6/15 Chat 3253 Corro. stop 100' oil 3332'  
 850' oil 3347 - 2000' 2 hrs 3352-03  
 T.D. 3253  
6/21 deepened 3356 swap 75 bbls 9 hrs  
 tubing and will acidize  
6/28 Top chat 3253  
 T.D. 3356  
 acidized 1000 gallons  
 320 bbls Cutting 4 %  
 COMPLETED

Reno

40 KANSAS

W

Map No. \_\_\_\_\_ Sec. 1 Twp. 23 R. 4

Well No. 1 Spring

Manning & Terry et al Company  
 Contractor

FIRST REPORTS

SECTION PLAT

330 Ft. from N. Line  
 \_\_\_\_\_ Ft. from S. Line  
 \_\_\_\_\_ Ft. from E. Line  
 330 Ft. from W. Line

		o	
		h	

Location \_\_\_\_\_

Rig up \_\_\_\_\_

Drilling and Remarks:

Cellar & Pond

RECORD

Cased \_\_\_\_\_ in., \_\_\_\_\_ ft.  
 Sand \_\_\_\_\_  
 Gas \_\_\_\_\_  
 Oil \_\_\_\_\_  
 Total Depth \_\_\_\_\_

PRODUCTION

1st 24 hrs. Nat. \_\_\_\_\_  
 1st 24 hrs. after shot \_\_\_\_\_  
 Gas \_\_\_\_\_ Cu. Ft.  
 Dry Hole \_\_\_\_\_  
 Abandoned \_\_\_\_\_

Date MAY 3 1933

192 CHAS. L. SHERWOOD Scout


Map No. 40 Sec. 1 Twp. 23 R. 4W

Well No. 1 Gocring

Manning-Terry et al Company  
Contractor

SECTION PLAT

330 Ft. from N. Line  
..... Ft. from S. Line  
..... Ft. from E. Line  
330 Ft. from W. Line

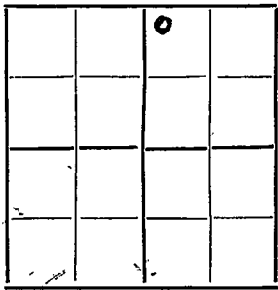

**COMPLETED**

Location.....

Rig up.....

Drilling and Remarks:

Chat 3253  
acidized  
1000 gallons  
320 bbls  
cutting 4%

RECORD

Cased..... in., ..... ft.  
Sand.....  
Gas.....  
Oil.....  
Total Depth 3356

PRODUCTION

1st 24 hrs. Nat.....  
1st 24 hrs. after shot.....  
Gas..... Cu. Ft.  
Dry Hole.....  
Abandoned.....

Date

6/28/33 Orval Manning