



Map No. KANSAS Sec. 1 Twp. 23 R. 4<sup>w</sup>

Well No. 1 - Faury Farm


Study, Turner & Frost Company

         Ft. from N. Line

330 Ft. from S. Line

330 Ft. from E. Line

1930 Ft. from W. Line

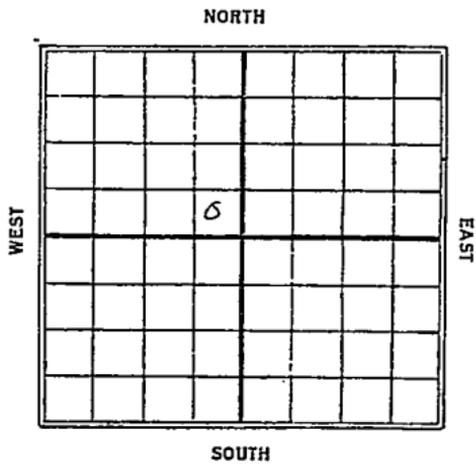

Date

REPORT

| Date  | REPORT                          |
|-------|---------------------------------|
| 10/22 | Pay up                          |
| 10/29 |                                 |
| 11/5  | h. Drlg. 240'                   |
| 11/12 | " 645'                          |
| 11/19 | " 1100'                         |
| 11/25 | " 1485'                         |
|       | 12" - 1467'                     |
| 12/3  | drlg 1680'                      |
| 12/10 | Log U/R logs 1925               |
| 12/17 | Drlg 2280'                      |
| 12/23 | " 2379'                         |
| 12/30 | " 2518'                         |
| 1931  |                                 |
| 1/7   | drlg 2643'                      |
| 1/14  | " 2735'                         |
| 1/21  | " 2846'                         |
| 1/28  | Run 8" - 2919' drlg             |
| 2/4   | U/R 8" - 3228'                  |
| 2/11  | drlg 3274'                      |
| 2/18  | Top chat 3254'                  |
|       | T.D. 3364 = 8 <sup>th</sup> gas |
|       | est 300 bbl oel                 |

2/25- T.D. 3364' Mkg  
8A gas and  
(est) 300 bbl oil

3/4- Chat 3254-3365  
T.D. 3365  
7A gas and  
flow 337 bbl, oil  
357 grav.  
Comp.

*Revd.*  
 Map No. **KANSAS** Sec. 1 Twp. 28 R. 4 W  
 Well No. 40 *1 Harry*

*Stacy, Turner & Frost* Company  
 Contractor

**SECTION PLAT**

.....Ft. from N. Line  
330 Ft. from S. Line  
330 Ft. from E. Line  
 .....Ft. from W. Line

|  |   |  |  |
|--|---|--|--|
|  |   |  |  |
|  |   |  |  |
|  | 0 |  |  |
|  |   |  |  |
|  |   |  |  |

**FIRST REPORTS**

Location.....  
 Rig up.....  
 Drilling and Remarks:

*Rigging up*  
*[Signature]*

**RECORD**

Cased..... in., .....ft.  
 Sand.....  
 Gas.....  
 Oil.....  
 Total Depth.....

**PRODUCTION**

1st 24 hrs. Nat.....  
 1st 24 hrs. after shot.....  
 Gas..... Cu. Ft.  
 Dry Hole.....  
 Abandoned.....

Date

OCT 22 1930

S. J. LEWIS Scout

Map No. **KANSAS** Sec. 1 Twp. 23 R. 4W

Well No. 1 Harry

Stacy, Harold Fred. Company  
Contractor

**SECTION PLAT**

|  |  |  |  |
|--|--|--|--|
|  |  |  |  |
|  |  |  |  |
|  |  |  |  |
|  |  |  |  |
|  |  |  |  |

\_\_\_\_\_ Ft. from N. Line

330 Ft. from S. Line

330 Ft. from E. Line

\_\_\_\_\_ Ft. from W. Line

**COMPLETED**

Location \_\_\_\_\_

Rig up \_\_\_\_\_

Drilling and Remarks:

*Flow 33788 1/2.*  
*35.7 gravity*

**RECORD**

Cased \_\_\_\_\_ in., \_\_\_\_\_ ft.

*Shot* Sand 3254 - 3365

Gas 7 1/4

Oil \_\_\_\_\_

Total Depth 3365

**PRODUCTION**

1st 24 hrs. Nat. \_\_\_\_\_

1st 24 hrs. after shot \_\_\_\_\_

Gas \_\_\_\_\_ Cu. Ft.

Dry Hole \_\_\_\_\_

Abandoned \_\_\_\_\_

Date

**MAR 4 1931**  
19

**S. J. LEWIS** Scout