

Form 51-5M-11-31-Palace

Map No. 24135 Sec. 1 Twp. 23 R. 4
Well No. 3 Harry (Haury) Farm
Frost & Otis Company

NORTH

TEST

EAST

SOUTH

Location_____

Drilling Remarks

Rig Up

Drilling Remarks

RECORD

Cased _____ in. _____ ft.

Sand

Gas

Oil

Total Depth_____

PRODUCTION

1st 24 hrs. Nat.-----

1st 24 hrs. after shot_____

Gas _____ cu. ft. _____

Dry Hole_____

Abandoned

Reno

Map No. KAN-CAS Sec. 1 Twp. 23 R. 40

Well No. J. Haney Farm


Frost & Study Company

330' Ft. from N. Line

_____ Ft. from S. Line

330' Ft. from E. Line

_____ Ft. from W. Line

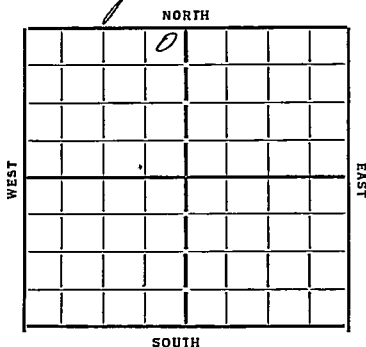

Date 1933

REPORT

11/22 Rat Rig

11/29 Rigging

12/6 12" at 48.5 W.D.C

12/13 1995 - O.D.

12/27 S.D 2926

1/4 Chat 3223 - RUST

1/11 Chat (corrected) 3236

T.D. 3320 - flow 62 bbls 1 hr

1/17 Treating with 1000 gal acid

1/24 —

1/31 Chat. Sand 3236 TD 3338

770 Bbls.

COMPLETED

Map No. 40 Sec. 1 Twp. 23 R. 4WWell No. 3 HarryFrost & Study Company

Contractor

FIRST REPORTS330 Ft. from N. Line

Ft. from S. Line

330 Ft. from E. Line

Ft. from W. Line

SECTION PLAT

	0		

Location.....

Rig up.....

Drilling and Remarks:

Rot Rig**RECORD**

Cased.....in.,ft.

Sand.....

Gas.....

Oil.....

Total Depth.....

PRODUCTION

1st 24 hrs. Nat.....

1st 24 hrs. after shot.....

Gas.....Cu. Ft.

Dry Hole.....

Abandoned.....

Date

1-22-33 O. Mannscheck 192

Map No. 40 Sec. 1 Twp. 23 R. 4W

Well No. 3-Harry

Frost & Glady Company

Contractor

COMPLETED

SECTION PLAT

330 Ft. from N. Line

..... Ft. from S. Line

330 Ft. from E. Line

..... Ft. from W. Line

	0		

Location.....

Rig up.....

Drilling and Remarks:

770 bbls

RECORD

Cased..... in., ft.

Sand Chat 3236

Gas.....

Oil.....

Total Depth: 3338

PRODUCTION

1st 24 hrs. Nat.....

1st 24 hrs. after shot.....

Gas..... Cu. Ft.

Dry Hole.....

Abandoned.....

Date

1-31-34 192 O. Y. Nammeh Scout