

KANSAS

Reno


Form 5I-5M-7-39-Palace

Section 1 Township 23 Range 4-W

Well No. ~~4 H.~~ Haury #1-A

Company Frost & Stucy

NORTH Burrton Pool

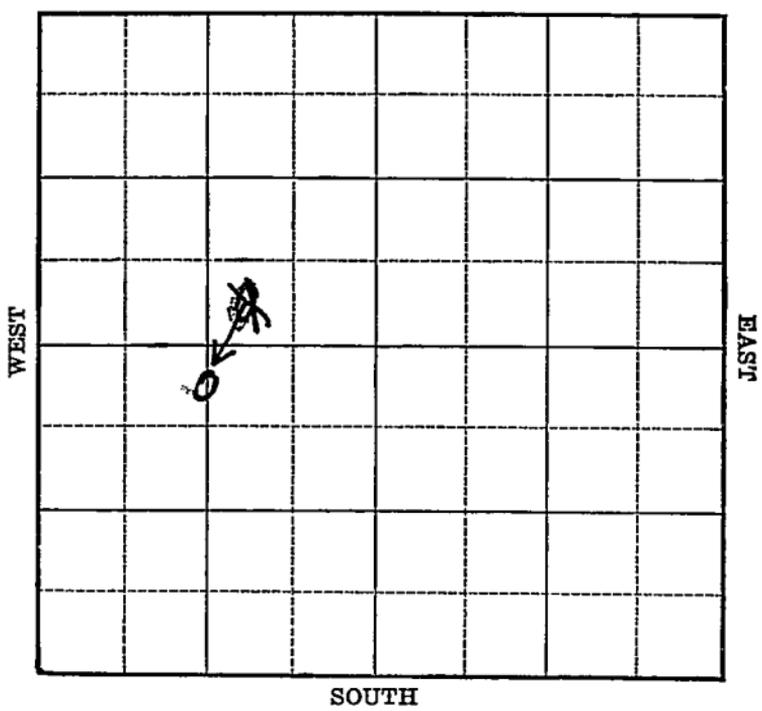

Sec. 1 Twp. 23 R. 4-W

Well No. #4 H. Haury #1 "A" Farm

Frost & Study Company

(Burrton)


330 Ft. from N. Line

330 Ft. from S. Line

~~990~~ Ft. from E. Line

1320 Ft. from W. Line

Elev. 1476

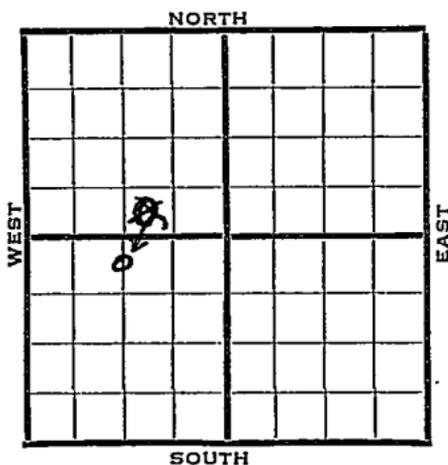

1940	REPORT
3/27	Cellar.
4/4	R.U.R.
4/12	12 1/2" - 285' Drlg. 1597'
4/18	K. C. 2530' Drlg. 3045'
4/25	8" - 3262' WOC.
5/2	Drlg. 3289'
5/9	S. Gas 3280-88'
	1 1/2 M gas 3332' Oil 3355-67 and
	3367'-79' Drlg. 3380'
5/16	T.D. 3397' 2000 acid.
5/22	Chat. 3259'
	8" - 3262'
	T.D. 3397'
	2000 acid.
	Pump 23 bbls.
	<b>COMPLETED</b>

Map No. 40 Sec. 1 Twp. 23 R. 4W

Well No. 4 H. Haury

Frost & Study Company

Contractor

**FIRST REPORT**

SW SE NW

\_\_\_\_\_ Ft. from N. Line

330 Ft. from S. Line

990 Ft. from E. Line

\_\_\_\_\_ Ft. from W. Line

**SECTION PLAT**


**BURRTON POOL**

Location \_\_\_\_\_

Rig up \_\_\_\_\_

Drilling and Remarks:

**cellar**

**RECORD**

Cased \_\_\_\_\_ in., \_\_\_\_\_ ft.

Sand \_\_\_\_\_

Gas \_\_\_\_\_

Oil \_\_\_\_\_

Total Depth \_\_\_\_\_

**PRODUCTION**

1st 24 hrs. Nat. \_\_\_\_\_

1st 24 hrs. after shot \_\_\_\_\_

Gas \_\_\_\_\_ Cu. Ft.

Dry Hole \_\_\_\_\_

Abandoned \_\_\_\_\_

Date

MAR 27 1940 19

S. J. LEWIS Scout

Map No. 40 Sec. 1 Twp. 23 R. 4W

Well No. 1 "A" Haury

Frost & Study Company

CORRECTION Contractor

SECTION PLAT

C N L SW


330 Ft. from N. Line

\_\_\_\_\_ Ft. from S. Line

\_\_\_\_\_ Ft. from E. Line

1320 Ft. from W. Line

BURRTO N POOL

Location \_\_\_\_\_

Rig up \_\_\_\_\_

Drilling and Remarks:

Reported as  
#4 Haury

SW SE NW

RECORD

Cased \_\_\_\_\_ in., \_\_\_\_\_ ft.

Sand \_\_\_\_\_

Gas \_\_\_\_\_

Oil \_\_\_\_\_

Total Depth \_\_\_\_\_

PRODUCTION

1st 24 hrs. Nat. \_\_\_\_\_

1st 24 hrs. after shot \_\_\_\_\_

Gas \_\_\_\_\_ Cu. Ft.

Dry Hole \_\_\_\_\_

Abandoned \_\_\_\_\_

Date

APR 16 1940<sub>19</sub>

S. J. LEWIS

Scout

Map No. 40 Sec. 1 Twp. 23 R. 4W

Well No. 1-A Haury

Frost & Study Company

Contractor

**COMPLETED**

**SECTION PLAT**

C N L SW

	o		

330 Ft. from N. Line

\_\_\_\_\_ Ft. from S. Line

\_\_\_\_\_ Ft. from E. Line

1320 Ft. from W. Line

BURRTON POOL

Location \_\_\_\_\_

Rig up \_\_\_\_\_

Drilling and Remarks:

*Chat. 3259*

*8" @ 3262*

*2000 acid*

*Pump 23 1/2*

**RECORD**

Cased \_\_\_\_\_ in., \_\_\_\_\_ ft.

Sand \_\_\_\_\_

Gas \_\_\_\_\_

Oil \_\_\_\_\_

Total Depth 3397

**PRODUCTION**

1st 24 hrs. Nat. \_\_\_\_\_

1st 24 hrs. after shot \_\_\_\_\_

Gas \_\_\_\_\_ Cu. Ft.

Dry Hole \_\_\_\_\_

Abandoned \_\_\_\_\_

Date

MAY 22 1940

S. J. LEWIS

Scout