

# KANSAS

Reno

Section 1 Township 23 Range 4W

Well No. 3 Geering

Company Tom Allan et al

Burnett  
NORTH

							0

WEST

EAST

SOUTH

9

KANSAS

Reno

Sec. 1 Twp. 23 R. 4W

Well No. #3 Goering Farm

Tom Allan et al Company


Burnett Pool

1186' Ft. from N. Line

\_\_\_\_\_ Ft. from S. Line

230' Ft. from E. Line

\_\_\_\_\_ Ft. from W. Line

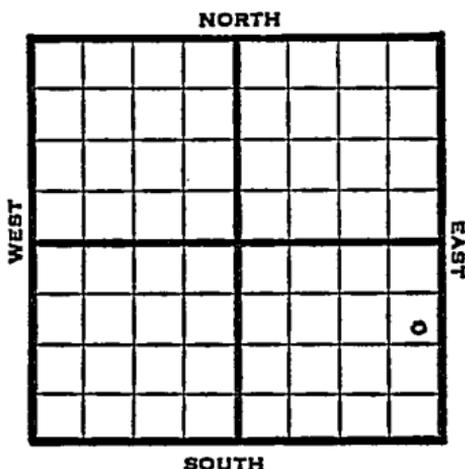

SE NE SE

1949 Elev 1486' REPORT

5/4 RUR

5/10 8" @ 298'  
Drlg. 1994'

5/18 Drlg 3170'

5/25 Miss 3277'  
5" @ 3344'  
TD 3367'

6/1 2000 acid

6/8 Miss 3277'  
5" @ 3344'  
TD 3367'

2000 acid

Pump 25 Oil / 25% W Pot

39° Gr.

Comp

**COMPLETED**

Map No. \_\_\_\_\_ Sec. 1 Twp. 23 R. 4W

Well No. 3 Goering

Tom Allan etal. Company

### FIRST REPORT

Contractor

SE NE SE


#### SECTION PLAT

1186 Ft. from N. Line

\_\_\_\_\_ Ft. from S. Line

230 Ft. from E. Line

\_\_\_\_\_ Ft. from W. Line

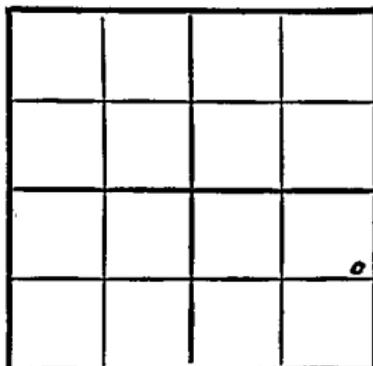

Reno County

#### RECORD

Location \_\_\_\_\_

Cased \_\_\_\_\_ in., \_\_\_\_\_ ft.

Rig up \_\_\_\_\_

Sand \_\_\_\_\_

Drilling and Remarks:

Gas \_\_\_\_\_

R U R

Oil \_\_\_\_\_

Total Depth \_\_\_\_\_

#### PRODUCTION

1st 24 hrs. Nat. \_\_\_\_\_

1st 24 hrs. after shot \_\_\_\_\_

Gas \_\_\_\_\_ Cu. Ft.

Dry Hole \_\_\_\_\_

Abandoned \_\_\_\_\_

Date

MAY 4 1949 19 \_\_\_\_\_

S. J. LEWIS Scout

Reno County Kansas State

Map No. K40 Sec. 1 Twp. 23 R. 4W

Well No. 3 Goering

Tom Allan et al. Company

**COMPLETE**

Contractor

*E 11486*

SE NE SE

SECTION PLAT

1186 Ft. from N. Line

         Ft. from S. Line

230 Ft. from E. Line

         Ft. from W. Line

							o

Burnett Pool

Remarks:

*Miss 3277*

*5" @ 3344*

*ND 3367*

*2000 acio*

*Pump 25' oil + 25% W.B.K.*

*39°/hr*

Date  
JUN 8 1949

Scout S. J. LEWIS