

Company Kantor Oil et al

EAST

SOUTH

15

Reno KANSAS

SEC.	TWP.	R.
1	23	4 W

WELL NO. ✓

COMPANY # 3 Goering FARM

CONTRACTOR Kantor Oil et al

Springer & Harper
Burrton Pool


Ft. from N. Line

710 Ft. from S. Line

Ft. from E. Line

430 Ft. from W. Line

NW SW SE

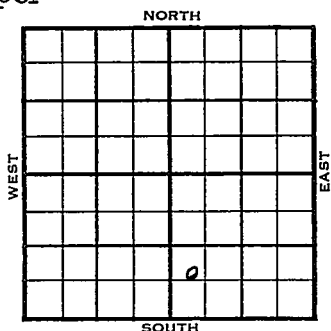

	ELEVATION	REPORT
1954	1498'	
4/7	Spud 4-3-54 8" @ 320 WOC	
5/19	Spud 4-3-54 Oil Well TD 3364' 8" @ 320' KC 2558', Miss 3307', TD 3337' 5" @ 3332' DD 3351' 18 goph 4 hr. frac. PB 3341' DD3364 10 go 11 gwph 2500 A S/ 63 bo. Comp 24 bopd.	COMPLETED

County **Reno** State **Kansas**

Sec. **1** (Blk. **23** (Sur. **4th** Map No.

Operator Kantor Oil etal.

Well No. **3** Farm **Goering**

Elev.	Location	NW	SW	SE
-------	----------	----	----	----

FIRST REPORT

710 Ft. From S Line SE

430 Ft. From ~~W~~ Line Quarter

1st. Report **APR 7 1954**

Completion

Remarks

Springer & Harper - Contr


Spudding Date **4-3-54**

Drig. Data Burrton Pool

8" @ 320 WOC

J. G. McGFHEE

County Reno State Kansas
 Sec. 1 (Bk.) 23 (Sur.) 4W Map No.
 Operator Kantor Oil etal.
 Well No. 3 Farm Goering
 Elev. 1498 Location NW SW SE

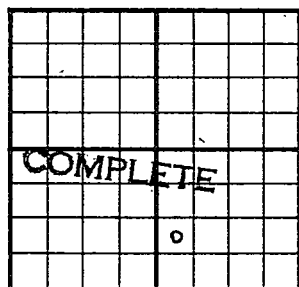

710 Ft. From S Line SE

430 Ft. From W Line Quarter

1st. Report

Completion MAY 19 1954

Remarks Burton Pool

Springer & Harper - Contr.

Spudding Date 4-3-54

Drig. Data Oil well TD 3364

8" @ 320 KC 2558 Miss. 3307

TD 3337 5" @ 3332 DD 3351 18 goph

4 hr. frac PB 3341 DD 3364 10 go

11 gwph 2500 A S/ 63 bo Comp. 24 bopd

J. G. McGEHEE