


Section 1 Township 22 23 Range 10 W

Well No. # 1 Baughman

Company B & R Drlg.

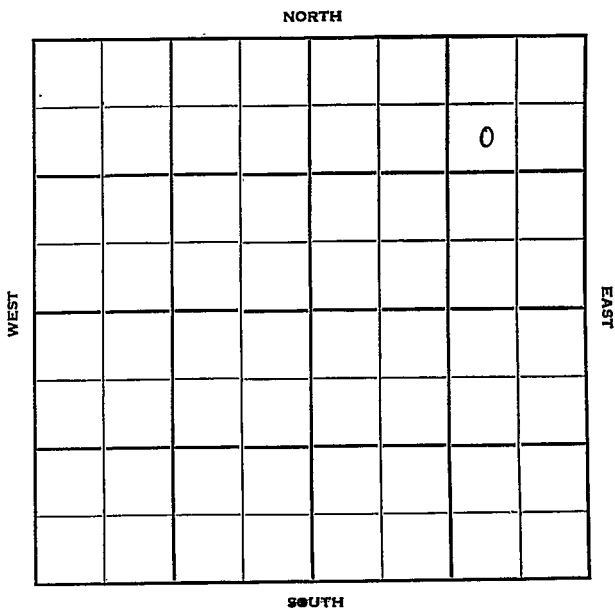

Sec. 1 Twp. 23 R. 10W

Well No. #1 Baughman Farm

B & R Drlg. Company

Contractor


Zenigh-Peace Creek Pool **NORTH**

990' Ft. from N. Line

Ft. from S. Line

990' Ft. from E. Line

Ft. from W. Line

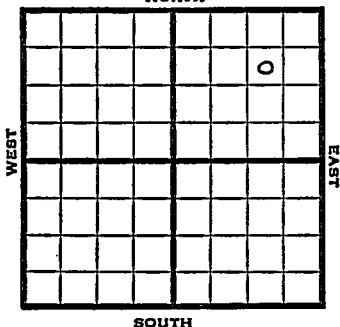

SW NE NE

1951 Elev. 1742' REPORT

6/27 Spud 6-18-51  
8" @ 258  
Herb 3052'  
BrL. 3225'  
Lans. 3232'  
Drlg. 3380'

7/11 Spud 6-18-51 D & A TD 3732'  
8" @ 258 Heeb 3052' Br. line 3225'  
Lans. 3232' Miss 3614' Kh 3625'  
Viola 3729' TD 3732' 5" @ 3730'  
water D & A

ABANDONED



Map No. \_\_\_\_\_ Sec. 1 Twp. 23 R. 10W

Well No. 1 Baughman

B & R Drlg. Company

**CORRECTION**

Contractor

SW NE NE

SECTION PLAT

990 Ft. from N. Line

\_\_\_\_\_ Ft. from S. Line

990 Ft. from E. Line

\_\_\_\_\_ Ft. from W. Line

			o

Reno County

Location \_\_\_\_\_

Rig up \_\_\_\_\_

Drilling and Remarks:

Reported

Sec. 1-22-10W

RECORD

Cased \_\_\_\_\_ in., \_\_\_\_\_ ft.

Sand \_\_\_\_\_

Gas \_\_\_\_\_

Oil \_\_\_\_\_

Total Depth \_\_\_\_\_

PRODUCTION

1st 24 hrs. Nat. \_\_\_\_\_

1st 24 hrs. after shot \_\_\_\_\_

Gas \_\_\_\_\_ Cu. Ft.

Dry Hole \_\_\_\_\_

Abandoned \_\_\_\_\_

Date

JUL 2 1951 19

J. E. TYRA

Scout

