

KANSAS

FORM 51 5M 10-41 PETROL

Reno

Section 1 Township 23 Range 10-W

Well No. #2 Baughman

Company Sinclair-Prairie

Hendrickson Pool

NORTH

				0			

WEST

EAST

SOUTH


7

Sec. 1 Twp. 23 R. 10-W

Well No. #2 Baughman Farm

Sinclair-Prairie Company

(Hendriksen-)
(Peace Creek)

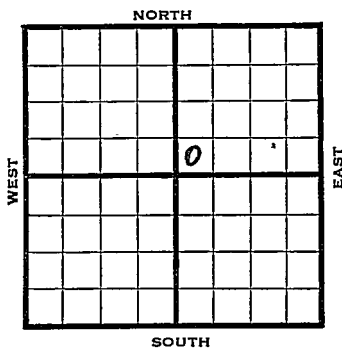

_____ Ft. from N. Line

330 Ft. from S. Line

_____ Ft. from E. Line

330 Ft. from W. Line

Elev. 1745

1942

REPORT

7/1	Derrick.		
7/8	"		
7/15	"		
7/22	"		
7/29	Rotary.		
8/5	Drlg. 2990'		
8/12	Drlg 3180		
8/19	Lans. 3240	Viola 3695-3703 T.D.	
	5" - 3696		
	RUST		
8/27	" "	"	
9/2	" "	"	
9/9	" "	"	
9/16	" "	"	
9/23	Drlg 3708-500 acid.		
9/30	Lansing 3240		
	Viola 3695		
	5" 3696		
	TD 3708		
	500 acid		
	Bomb Pot. 14,576 bopd		
	42 Grav.		

COMPLETED

KANSAS

Map No. 47 Sec. 1 Twp. 23 R. 10W

Well No. 2 Baughman

Sinclair-Prairie Company

Contractor

SW NE

SECTION PLAT

_____ Ft. from N. Line

330 Ft. from S. Line

_____ Ft. from E. Line

330 Ft. from W. Line

		o	

Peace Creek
~~HENDRICKSON POOL~~

Location

500 Acid

Drilling and Remarks:

Bomb Pot,
14,576 Bop d

42 grav

RECORD

Cased 5 in., 3696 ft.

Sand _____

Gas _____

Oil _____

Total Depth 3708

PRODUCTION

1st 24 hrs. Nat. _____

1st 24 hrs. after shot _____

Gas _____ Cu. Ft.

Dry Hole _____

Abandoned _____

Date

COMPLETED

SEP 30 1942 19

S. J. LEWIS Scout

Lansing 3240
Viola 3695

Misc. Small Maps	<i>Boyer</i>
Cards	<i>Boyer</i>
Tracing	<i>Boyer</i>
France Map	<i>Boyer</i>
Scarborough Map	<i>Boyer</i>
Moody Map	
Geological Erupt	
Mossy Flat Beck	