


Section 1 Township 23 Range 10-W

Well No. #4 Keesling "B"

Company Cities Service Oil

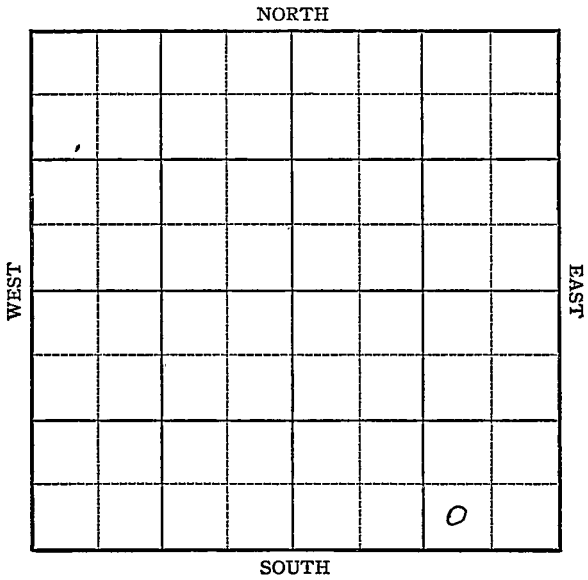

Sec. 1 Twp. 23 R. 10-W

Well No. #4 Keesling "B" Farm

Cities Service Oil Company


Peace Creek

 Ft. from N. Line

330 Ft. from S. Line

990 Ft. from E. Line

 Ft. from W. Line

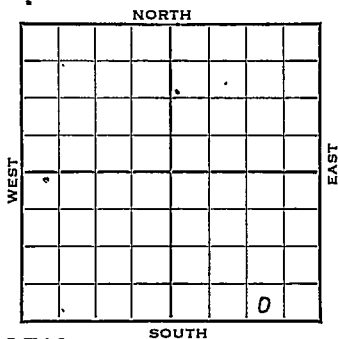

SW SE SE

Elev. 1749

REPORT	
1943	
1/13	Surface hole.
1/20	10" Casing set 195' Drlg. 2070'
1/27	Drlg. 3140'
2/3	Drlg. 3727'
2/10	Lans 3240 Cong 3588 Kind 3622 Viola 3731 7" Casing set 3732-34 TD RUST
2/17	Pump 227 Temp. Pot.:
2/24	Viola 3731 7" @ 3732' T.D. 3734' Pump 227 pot. Gravity 42

COMPLETED

Reno

KANSAS
 Map No. Sec. 1 Twp. 23 R. 10W

Well No. 4 Keesling "B"

Cities Service Oil Company

FIRST REPORT Contractor

SW SE SE

SECTION PLAT

_____ Ft. from N. Line

330 Ft. from S. Line

990 Ft. from E. Line

_____ Ft. from W. Line

			0

PEACE CREEK POOL

Location _____

Rig up _____

Drilling and Remarks:

Surface Hole

RECORD

Cased _____ in., _____ ft.

Sand _____

Gas _____

Oil _____

Total Depth _____

PRODUCTION

1st 24 hrs. Nat. _____

1st 24 hrs. after shot _____

Gas _____ Cu. Ft.

Dry Hole _____

Abandoned _____

Date

JAN 13 1943 19

S. J. LEWIS Scout

Reno

Map No. ~~KANSAS~~ Sec. 1 Twp. 23 R. 10W

Well No. 4 Keesling "B"

Cities Service Oil Company

COMPLETED

Contractor

SW SE SE

SECTION PLAT

_____ Ft. from N. Line

330 Ft. from S. Line

990 Ft. from E. Line

_____ Ft. from W. Line

PEACE CREEK POOL

Location _____

Rig up _____

Drilling and Remarks:

Viola 3731
7" @ 3732

Pump 227 Pt.

42 @ 3732

RECORD

Cased _____ in., _____ ft.

Sand _____

Gas _____

Oil _____

Total Depth 3734

PRODUCTION

1st 24 hrs. Nat. _____

1st 24 hrs. after shot _____

Gas _____ Cu. Ft.

Dry Hole _____

Abandoned _____

Date

FEB 24 1943 19

S. J. LEWIS Scout