

KANSAS

Reno


FORM 51 5M 4-41 PETROL

Section 1 Township 23 Range 10-W

Well No. #1 Withroder

Company Transwestern

NORTH Hendrickson Pool

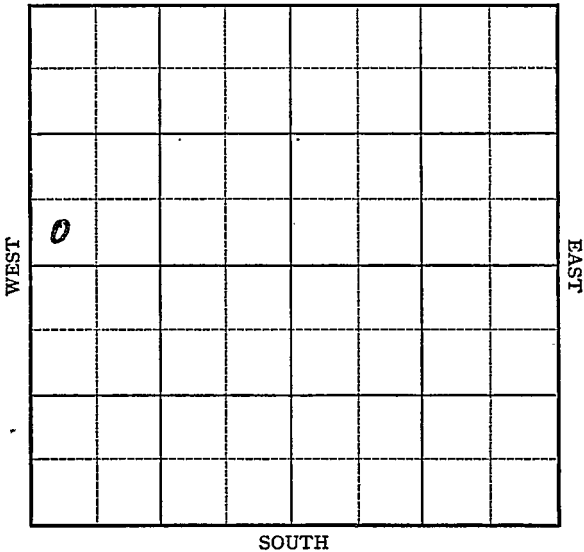

5

Sec. 1 Twp. 23 R. 10-W

Well No. #1 Withroder Farm

Transwestern Company

(Hendrickson)


_____ Ft. from N. Line

330 Ft. from S. Line

_____ Ft. from E. Line

330 Ft. from W. Line

Elev. 1747

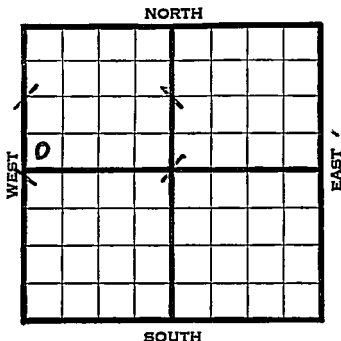

1942

REPORT

5/20

Rotary.

5/27

8" - 242' Drlg. 2635'

6/3

Drlg. 3410'

6/10

Lans. 3230' Misener 3699'

Viola 3702-06' T.D. 5" - 3706' RUST.

6/17

Viola 3702'

5" - 3706'

T.D. 3725'

2000 acid.

Bomb potential 16,937 bbls.

Maximum 3000 bbls.

42. Gravity

COMPLETED

Map No. 47 Sec. 1 Twp. 23 R. 10WWell No. 1 WithroderTranswestern Company**FIRST REPORT** Contractor


SW NW

SECTION PLAT

_____ Ft. from N. Line

330 Ft. from S. Line

_____ Ft. from E. Line

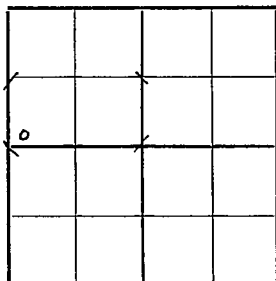330 Ft. from W. LineHENDRICKSON POOL

Location _____

Rig up _____

Drilling and Remarks:

Rotary

RECORD

Cased _____ in., _____ ft.

Sand _____

Gas _____

Oil _____

Total Depth _____

PRODUCTION

1st 24 hrs. Nat. _____

1st 24 hrs. after shot _____

Gas _____ Cu. Ft.

Dry Hole _____

Abandoned _____

Date

MAY 20 1942 19S. J. LEWIS Scout

Map No. 47 Sec. 1 Twp. 23 R. 10W

Well No. 1 Withroder

Transwestern Company

COMPLETED Contractor

SW NW

SECTION PLAT

_____ Ft. from N. Line

330 Ft. from S. Line

_____ Ft. from E. Line

330 Ft. from W. Line

HENDRICKSON POOL

Location _____

Rig up _____

Drilling and Remarks:

Vidla 3702
5" @ 3706
2000 acid
Bonded 16937
M-3000
42 @ 37

RECORD

Cased _____ in., _____ ft.

Sand _____

Gas _____

Oil _____

Total Depth 3725

PRODUCTION

1st 24 hrs. Nat. _____

1st 24 hrs. after shot _____

Gas _____ Cu. Ft.

Dry Hole _____

Abandoned _____

Date

JUN 17 1942 19

S. J. LEWIS Scout