

KANSAS

FORM 51 5M, 4-41 PETROL


Reno

Section 1 Township 23 Range 10-W

Well No. #2 Withroder

Company Transwestern

NORTH Peace Creek Pool

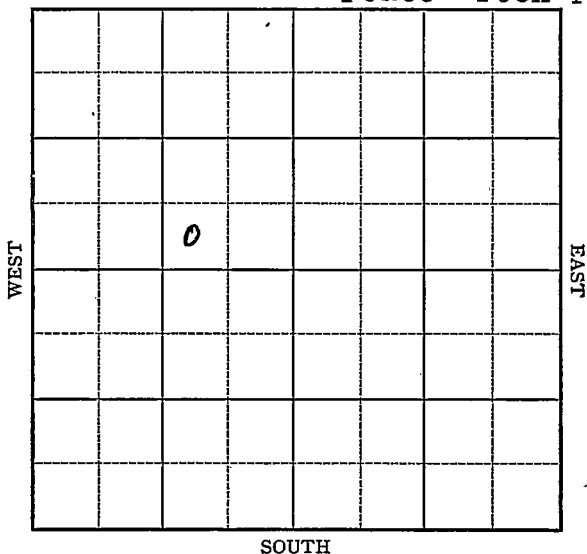

Sec. 1 Twp. 23 R. 10-W

Well No. #2 Withroder Farm

Transwestern Company

(Peace Creek)


_____ Ft. from N. Line

330 Ft. from S. Line

990 Ft. from E. Line

_____ Ft. from W. Line

Elev. 1742

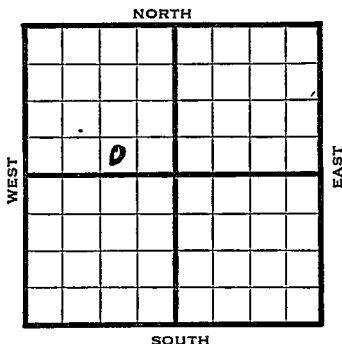

1942

REPORT

6/24

Location

7/1

Surface hole.

7/8

8" - 248' Drlg. 3126' 3700'

7/15

Lans. 3219' Viola ~~3602-071' T.D.~~

5" - 3694' RUST.

7/22

Viola 3700 (Corrected)

5" - 3701

T.D. 3712

Flow 128 oil in 2hrs.

7/29

Viola 3700'

5" - 3701'

T.D. 3712

Bomb Pot. 154893

Max. 3000

Gravity 42.

COMPLETED

Map No. 47 Sec. 1 Twp. 23 R. 10WWell No. 2 WithroderTranswestern CompanyFIRST REPORT Contractor

S W SE NW

SECTION PLAT

 Ft. from N. Line330 Ft. from S. Line990 Ft. from E. Line Ft. from W. Line

	o		

PEACE CREEK POOLLocation XXXRig up Drilling and Remarks:

RECORD

Cased in., ft.Sand Gas Oil Total Depth

PRODUCTION

1st 24 hrs. Nat. 1st 24 hrs. after shot Gas Cu. Ft.Dry Hole Abandoned

Date

JUN 24 194219S. J. LEWISScout

Reno

Map No. 47 Sec. 1 Twp. 23 R. 10W

Well No. 2 Withroder

Transwestern Company

COMPLETED Contractor

SW SE NW

SECTION PLAT

_____ Ft. from N. Line

330 Ft. from S. Line

990 Ft. from E. Line

_____ Ft. from W. Line

PEACE CREEK POOL.

RECORD

Location _____

Cased _____ in., _____ ft.

Rig up _____

Sand _____

Drilling and Remarks:

Gas _____

Vista 3700

Oil _____

5" @ 3701

Total Depth 3712

Born & Pat 154893

Map 3000

PRODUCTION

1st 24 hrs. Nat. _____

1st 24 hrs. after shot _____

Gas _____ Cu. Ft.

Dry Hole _____

Abandoned _____

42 0/8

Date

JUL 29 1942 19

S. J. LEWIS Scout