


Section 1 Township 23 Range 10-W

Well No: #2 Keesling

Company Cities Service Oil

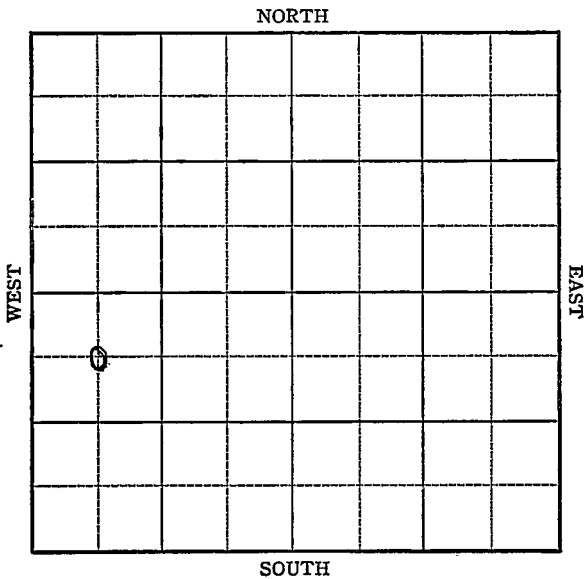

Sec. 1 Twp. 23 R. 10-W

Well No. #2 Keesling Farm

Cities Service Oil Company

(Peace Creek)


660 Ft. from N. Line

_____ Ft. from S. Line

_____ Ft. from E. Line

660 Ft. from W. Line

Elev. 1754

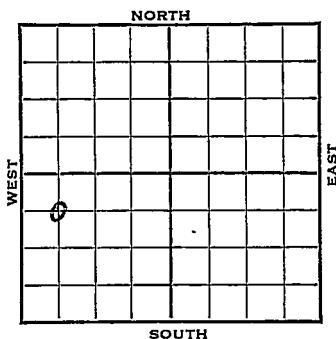

1942

REPORT

7/15 8" - 160'
Drlg. 1355'

7/22 Drlg. 3143'

7/29 Viola ~~3727~~³⁷²⁴ - 28 T.D.
5" - 3724 RUST.

8/5 Viola 3724 (corrected)
5" - 3727-39 T.D.
Flow 120' oil 5 hrs.

8/12 Viola 3724
5" - 3727
T.D. 3739
Bomb Pot. 3000
Gravity 42.

COMPLETED

Reno

KANSAS

Map No. 47 Sec. 1 Twp. 23 R. 10W.Well No. 2 KeeslingCities Service Oil CompanyFIRST REPORT Contractor

C NW SW

SECTION PLAT

o			

660 Ft. from N. Line

_____ Ft. from S. Line

_____ Ft. from E. Line

660 Ft. from W. LinePEACE CREEK POOL

Location _____

Rig up _____

Drilling and Remarks:

8" - 160'

Drlg. 1355'

RECORD

Cased _____ in., _____ ft.

Sand _____

Gas _____

Oil _____

Total Depth _____

PRODUCTION

1st 24 hrs. Nat. _____

1st 24 hrs. after shot _____

Gas _____ Cu. Ft.

Dry Hole _____

Abandoned _____

Date

JUL 15 1942

19

S. J. LEWIS

Scout

Map No. 47 Sec. 1 Twp. 23 R. 10W

Well No. 2 Keesling

Cities Service Oil Company

COMPLETED Contractor

SECTION PLAT

C NW SW
660 Ft. from N. Line

_____ Ft. from S. Line

_____ Ft. from E. Line

660 Ft. from W. Line

2			

PEACE CREEK POOL

Location _____

Rig up _____

Drilling and Remarks:

Vidlar 3724
5" @ 3727
Born & Pa 3000

420 gr

RECORD

Cased _____ in., _____ ft.

Sand _____

Gas _____

Oil _____

Total Depth 3789

PRODUCTION

1st 24 hrs. Nat. _____

1st 24 hrs. after shot _____

Gas _____ Cu. Ft.

Dry Hole _____

Abandoned _____

Date

AUG 12 1942 19

S. J. LEWIS Scout