

KANSAS

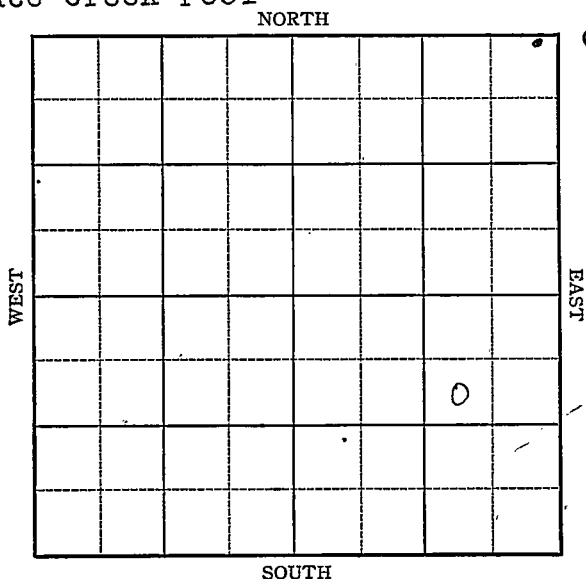
Reno

Section 1 Township 23 Range 10-W

Well No. #3 Keesling "B"

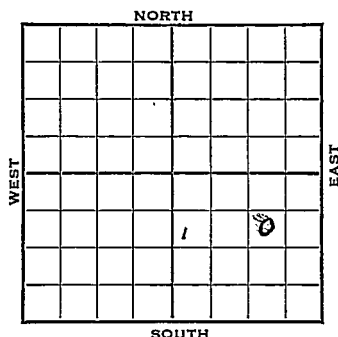
Company Cities Service Oil

Peace Creek Pool



KANSAS

Reno

Sec. 1 Twp. 23 R. 10-WWell No. #3 Keesling "B" FarmCities Service Oil Company990 Ft. from N. Line Ft. from S. Line990 Ft. from E. Line Ft. from W. LinePeace Creek pool *Elev. 1762*

1942

REPORT

11/24

Loc.

12/2

10" @ 222
Drlg. 2850

12/9

Viola 3723-25

TD run csg

12/16

7" @ 3724
TD 3748 SD

12/22

500 acid swab 147 bbls oil in 18 hrs.

12/29

" " " "

1943

1/6

Viola 3723

7" - 3724

500 acid

Bomb Pot. 824 oil and 92 water

Gravity 42.

T.D. 3748

COMPLETED

SAS
KANSASMap No. 47 Sec. 1 Twp. 23 R. 10WWell No. 3 Keesling "B"Cities Service Oil Company**FIRST REPORT**

Contractor

SW NE SE

SECTION PLAT990 Ft. from N. Line Ft. from S. Line990 Ft. from E. Line Ft. from W. Line

PEACE CREEK POOL

Location XXXRig up

Drilling and Remarks:

RECORDCased in., ft.Sand Gas Oil Total Depth **PRODUCTION**1st 24 hrs. Nat. 1st 24 hrs. after shot Gas Cu. Ft.Dry Hole Abandoned

Date

NOV 24 1942 19 S. J. LEWIS Scout

KANSAS

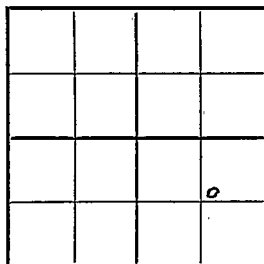
Map No. 47 Sec. 1 Twp. 23 R. 10WWell No. 3 Keesling "B"Cities Service Oil Company

COMPLETED

Contractor

SW NE SE

SECTION PLAT

990 Ft. from N. Line Ft. from S. Line990 Ft. from E. Line Ft. from W. Line

PEACE CREEK POOL

Location Rig up

Drilling and Remarks:

Virta 3723
7" C 3724
500 acid
Bam X P 824 oil
+ 92 water

42 e Gr

RECORD

Cased in., ft.Sand Gas Oil Total Depth 3748

PRODUCTION

1st 24 hrs. Nat. 1st 24 hrs. after shot Gas Cu. Ft.Dry Hole Abandoned

Date

JAN 6 1943 19 S. J. LEWIS Scout