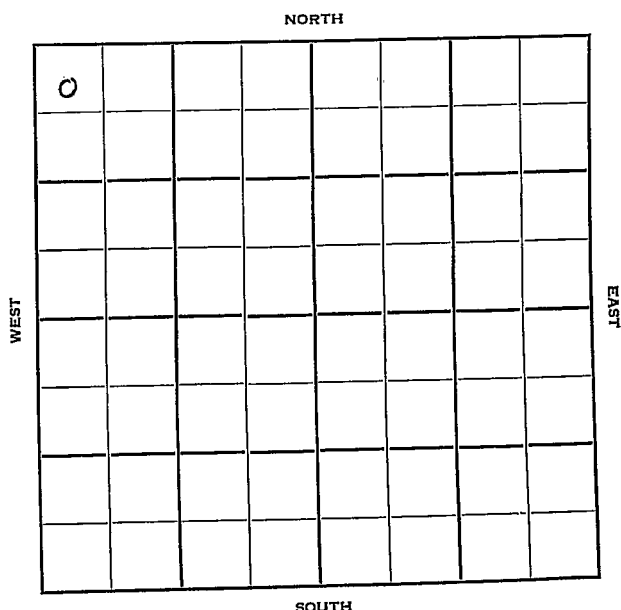


Section 1 Township 23 Range 13-WWell No. #1 Witt Jr.Company Finston & Murfin et al

KANSAS

Stafford

Sec. 1 Twp. 23 R. 13-W ✓

Well No: #1 Witt Jr. Farm

Finston & Murfin et al Company

Murfin Contractor

Wildcat


330 Ft. from N. Line

Ft. from S. Line

Ft. from E. Line

330 Ft. from W. Line

NW NW NW

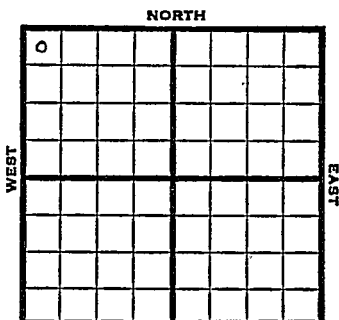

Mag & Sinc. DHM Skelly

1950

Elev 1859

REPORT

6/7

Location

7/12

8 5/8" @ 254

Anhy 720-45

Heeb 3237

Br lime 3375

Lans 3393

soft 3481-91

Cong 3655

Viola 3695

Simp 3737

Arb 3810

DST 3810-15 opn 1/2 hr rec 1' free oil

30" ocm

EST 3810-20 opn 1/2 hr, rec 20' mud

5" @ 3811

FU 5 bo

S/4 1/2 bo 16 hr

1500 acid

S/76 bo 7 hr

Comp 60 bopd 26 gravity

COMPLETED

Kansas

Map No. _____ Sec. 1 Twp. 23 R. 13WWell No. 1 Witt Jr.Finston & Murfin et al CompanyMurfin Contractor

NW NW NW

330 Ft. from N. Line

_____ Ft. from S. Line

_____ Ft. from E. Line

330 Ft. from W. Line

SECTION PLAT

0			
FIRST		REPORT	

Stafford May + Sinc. DHM Skelly

Location _____

Rig up _____

Drilling and Remarks:

RECORD

Cased _____ in., _____ ft.

Sand _____

Gas _____

Oil _____

Total Depth _____

PRODUCTION

1st 24 hrs. Nat. _____

1st 24 hrs. after shot _____

Gas _____ Cu. Ft.

Dry Hole _____

Abandoned _____

Date

JUN 7 1950 19 J. E. TYRA Scout

Map No. _____ Sec. 1 Twp. 23 R. 13WWell No. 1 Witt Jr.

_____ Finston & Murfin et al. _____ Company

_____ Contractor

N¹ N¹7 N¹7El. 1859
SECTION PLAT330 Ft. from N. Line

_____ Ft. from S. Line

_____ Ft. from E. Line

330 Ft. from W. Line

Stafford County -

Location _____

Rig up _____

Drilling and Remarks:

8 5/8" C 254

Anhy 720-45

Heeb. 3237

Br. lime 3375

Lans. 3393

soft 3481-91

Conc. 3655

RECORD

Cased _____ in., _____ ft.

Sand _____

Gas _____

Oil _____

Total Depth 3820

PRODUCTION

1st 24 hrs. Nat. _____

1st 24 hrs. after shot _____

Gas _____ Cu. Ft.

Dry Hole _____

Abandoned _____

Date

JUL 12 1950 19 J. E. TYRA Scout

Viola 3695

Simp. 3737

Arb. 3810

DST 3810-15

open 1/2 hr.

Rec. 1' free oil

DST 3810-20

open 1/2 hr.

Rec. 20' mud

5" C 3811

TD 3820

FU 5 bo

S/ 4 1/2 bo 16 hr.

1500 acid

S/ 76 bo 7 hr.

Comp. 60 bopd 26 gravity

Misc.
Pierce Map
France Map
Tracings
Land Wall Map
Land Small Map
Scout Cards