

KANSAS


FORM 51 5M 10-41 PETROL

Stafford

Section 1 Township 23 Range 14-W

Well No. #1 Liberty Life

Company Cities Service Oil

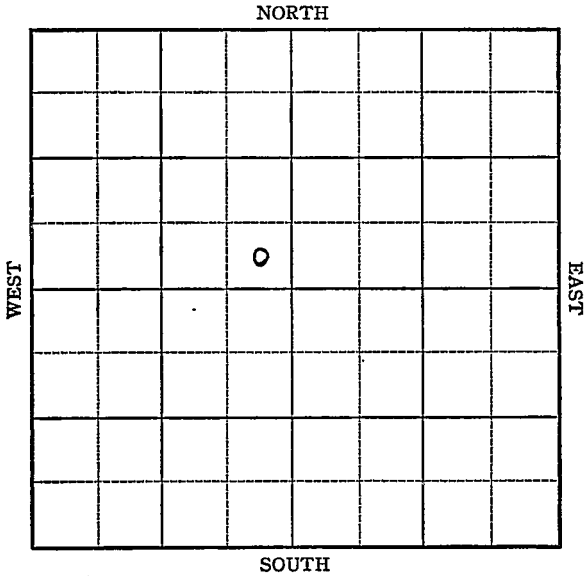

Sec. 1 Twp. 23 R. 14-W

Well No. #1 Liberty Life Farm

Cities Service Oil Company

(Wildcat)


_____ Ft. from N. Line

330 Ft. from S. Line

330 Ft. from E. Line

_____ Ft. from W. Line

Elv. 1937

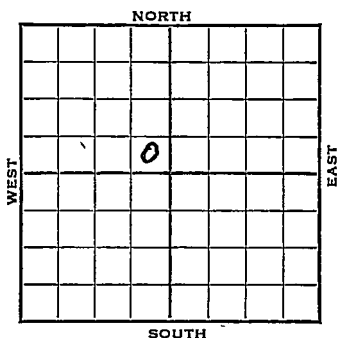

1942

REPORT

7/15

Rotary.

7/22

8" @ 409

Drlg. 1995'

7/29

Anhy 800

Topeka 3025'

Drlg. 3175'

8/5

Viola 3790'

Simp. 3823'

Arb. 3883'

No shows

T.D. 3913'

ABANDONED

Stafford KANSAS

Map No. 3 Sec. 1 Twp. 23 R. 14WWell No. 1 Liberty LifeCities Service Oil CompanyFIRST REPORT Contractor

SE NW

SECTION PLAT

_____ Ft. from N. Line

330 Ft. from S. Line330 Ft. from E. Line

_____ Ft. from W. Line

		o	

WILDCAT

Location _____

Rig up _____

Drilling and Remarks:

Rotary

RECORD

Cased _____ in., _____ ft.

Sand _____

Gas _____

Oil _____

Total Depth _____

PRODUCTION

1st 24 hrs. Nat. _____

1st 24 hrs. after shot _____

Gas _____ Cu. Ft.

Dry Hole _____

Abandoned _____

Date

JUL 11 1942 19S. J. LEWIS Scout

Map No. 83 Sec. 1 Twp. 23 R. 14W

Well No. 1 Liberty Life

Cities Service Oil Company

ABANDONED Contractor

SE NW

SECTION PLAT

_____ Ft. from N. Line

330 Ft. from S. Line

330 Ft. from E. Line

_____ Ft. from W. Line

WILDCAT

Location _____

Rig up _____

Drilling and Remarks:

Vista 3790
Imp. 3823
Cr 3883
Nashville

RECORD

Cased _____ in., _____ ft.

Sand _____

Gas _____

Oil _____

Total Depth 3913

PRODUCTION

1st 24 hrs. Nat. _____

1st 24 hrs. after shot _____

Gas _____ Cu. Ft.

Dry Hole _____

Abandoned _____

Date

AUG 5 1942 19

S. J. LEWIS Scout