

Pawnee

DX 78-1

KANSAS

Section 1 Township 23S Range 17W

Well No. #1 Lanterman

Company Hilton

NORTH

0							

WEST

EAST

SOUTH

SEC.	1	TWP.	23S	R.	17W
------	---	------	-----	----	-----

WELL NO. #1 Lanterman FARM

COMPANY Hilton

CONTRACTOR Co. Tools.


Wildcat. (E. Jab Pool)

330 Ft. from N. Line

Ft. from S. Line

Ft. from E. Line

330 Ft. from W. Line

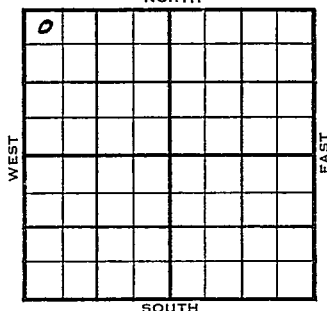

NW NW NW

1954	ELEVATION	REPORT
	2066'	

12/8 Location

1955
2/99

Spud 12-12-54 - OilWell
 TD 4258'
 8" @ 222'
 Heeb. 3602', Br lime 3709', Lans 3718',
 Cong. 4141'
 DST 4131-58', opn 1½ hrs., gas in 3",
 spray oil 50", 3,120,000 cfg, 780'
 clean oil 1240#
 DST 4158-85', opn 1 hr., rec. 15' mud,
 70#
 DST 4185'-4213', opn 1 hr., rec. 40'
 mud, VSSO 105#
 Viola 4230'
 TD 4258'
 5" @ 4257'
 36/4150-56, dry
 d-oil-frac, F/60 bo 10 hrs.
 Comp. F/30 bopd

COMPLETED


Sec. 1 (Blk. Twp.) 23S (Sur. Rge.) 17W Map No.

Operator Hilton

Well No. 1 Farm Lanternman

Elev. Location NW NW NW

0							

330 Ft. From N Line

330 Ft. From W Line NW Quarter

Ist. Report DEC 8 1954

Completion

Remarks Co. tools

Spudding Date

Drlg. Data Wildcat

Log

County Pawnee State KansasSec. 1 (Blk. Twp.) 23 (Sur. Rge.) 17W Map No.Operator Hilton Drlg.Well No. 1 Farm LantermanElev. 2066 Location NW NW NW

0					

330 Ft. From N Line NW330 Ft. From W Line Quarter

Ist. Report

Completion FEB 9 1955Remarks E. Jab PoolCo. toolsSpudding Date 12-12-54Drlg. Data Oil well TD 42588" @ 222 Heeb. 3602 Br. line 3709Lans. 3718 Cong. 4141 DST 4131-58open 1½ hr. gas in 3 min. spray oil50 min. 3,120,000 cfg 780' clean oil1240# DST 4158-85 open 1 hr. Rec.15' mud 70# DST 4185-4213 open 1 hr.Rec. 40' mud VSSO 105# Viola 4230TD 4258 5" @ 4257 36/ 4150-56 drysd-oil-frac F/ 60 bo 10 hr.Comp. F/ 30 bopd

FABEN GILSTRAP