


Section 1 Township 23 Range 17W

Well No. #1 Schartz

Company Colorado Oil & Gas & Honaker & Coppinger.

NORTH

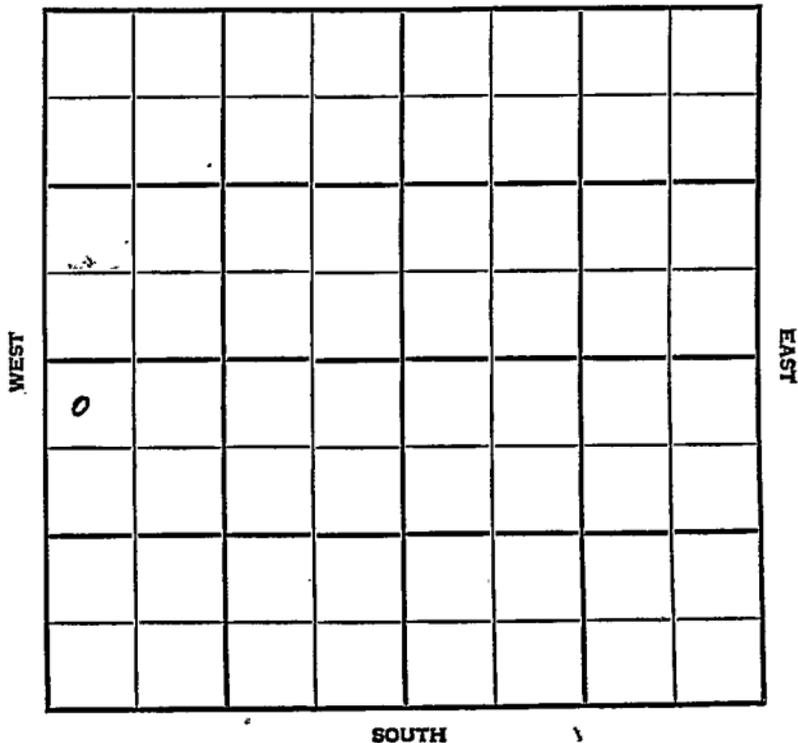

SOUTH

Pawnee KANSAS

SEC.	TWP.	R.
1	23	17W


WELL NO. 1 Schartz FARM

COMPANY Colorado Oil & Gas & Honaker &

CONTRACTOR Coppinger
Honaker Drlg.

Garfield

330 _____ Ft. from N. Line
 _____ Ft. from S. Line
 _____ Ft. from E. Line
 330 _____ Ft. from W. Line

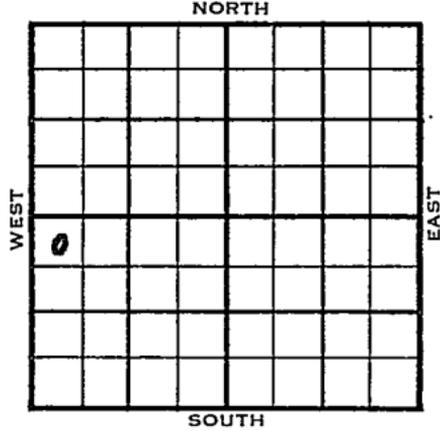

NW NW SW

1955	ELEVATION	REPORT
	2075' KB	

3/9
3/30

Location
 S
 pud 3-12-55 - D&A
 TD 4395'
 8" @ 249'
 Heeb. 3595', Br lime 3704', ^Lans 3714',
 Cong. 4114'
 DST 4130-70', opn 1 hr., rec. 25' mud,
 O#
 DST 4182-4210', op 1 hr., rec. 90'
 GCM, 880#
 Viola 4215'
 DST 4215-40', opn 45", rec. 40' mud,
 O#
 Simp. 4310', Arb. 4380'
 TD 4395'
 D&A

ABANDONED

