

DX 78-1

Pawnee

KANSAS

Section 1 Township 23 Range 18W

Well No. 1 Morrow "B"

Company Carl Todd Drlg.

NORTH

WEST	0						EAST

SOUTH

SEC.	TWP.	R.
1	23	18 W

WELL NO. # 1 Morrow "B" FARM

COMPANY
 Contractor Carl Todd Drlg.

CONTRACTOR


Wildcat

_____ Ft. from N. Line

_____ Ft. from S. Line

_____ Ft. from E. Line

_____ Ft. from W. Line

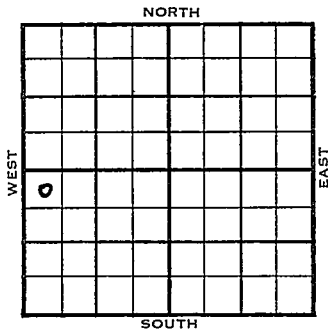

NW NW SW
 3/4 Mile - SD-X
 NCRA & NACC support

	ELEVATION	REPORT
1955	2100'	
7/6	Comm. 6-30-55 8" @ 238/175 Drlg. 2815'	
7/14	Heeb 3712, Br. lime 3816, Lans 3825, BKC 4150, Ce. 4260, Miss 4321, Kh. sd 4387, Rh. sh. 4395, DST 4325-37, open 1 hr. rec 100' vso & gcm, 10' wtry mud 840#, DST 4341-4400.	
7/22	DST 4341-4400, open 1 hr. Rec. 120' gcm, 100' sw, 1320#, D&A, holding for log tops.	
7/27	Comm 6-30-55 Anh 317 1175 H 3712 3711 BL 3816 L 3825 3822 BKC 4150 4150 Ce 4260 M 4321 4322 K sd 4387 4386 K sh 4395 V 4441 4441 TD 4462 4462 8" @ 238/175 DST 4325-37 open 1 hr	

1955

7/27 Rec 110' vso & gcm 10' wtry mud
840# DST 4341-4400 open 1 hr
Rec 120' gcm 100' sw 1320#
D & A

ABANDONED

County Pawnee Elev. _____
 Sec. 1 Twp. 23 Rge. 18W
 Company Carl Todd Drig.
 Farm Name Norow "B" No. 1

TOPS	DEPTH	LOG	DATUM
Anh.			
Tp.			
H.			
Tr.			
Dg.			
Bl.			
L.			
K.C.			
B.K.C.			
Ce.			
C.			
M.			
M.			
K.			
Mz.			
Ma.			
V.			
S.			
S.			
A.			
R.			
Pe.			
G.			
T.D.			

Loc. in Sec. NW NW SW
 Geol. _____
 Contr. _____
 Pool Wildcat

3/4 mile SW
1/6
FIRST REPORT
JUL 16 '55

Date Comm. 6-30-55 NCRA & NACC support
8th @ 233/175 drig. 2815

14

Co.
Lse.
No.
Sec.
T.
R.

County Pawnee Elev. 2100

Sec. 1 Twp. 23 Rge. 18W

Company Carl Todd Drlg.

FarmName Morrow "B" No. 1


TOPS	DEPTH	LOG	DATUM
Anh.		1175	
TP.			
H.	2712	2711	11011
Tr.			
Dg.			
Bl.	2816		1716
L.	3825	3822	1722
K.C.			
B.K.C.	4150	4150	2050
Ce.	4260		2160
C.			
M.	4321	4322	2222
M.			
K.	4287	4280	2286
Ma. <i>R 82</i>	4395		2295
Ma.			
V.	4441	4441	2341
S.			
S.			
A.			
R.			
PE.			
G.			
T.D.	4462	4462	

Loc. in Sec. NW NW SW

Geol. _____

Contr. _____

Pool Wildcat

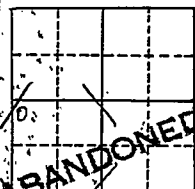

ABANDONED

Date Comm. 6-30-55 **JUL 27 1955**

8" @ 238/175 DST 4325-37, open 1 hr.

Rec. 110' vso & gcm 10' wtry mud 840#

DST 4341-4400 open 1 hr. Rec. 120'

gcm 100' sw = 1320#

D & A

Co.

Loc.

No.

Sec.

T.

R.