


Section 1 Township 23 Range 19-W

Well No. #1 Boyd

Company Stanolind

NORTH Wildcat

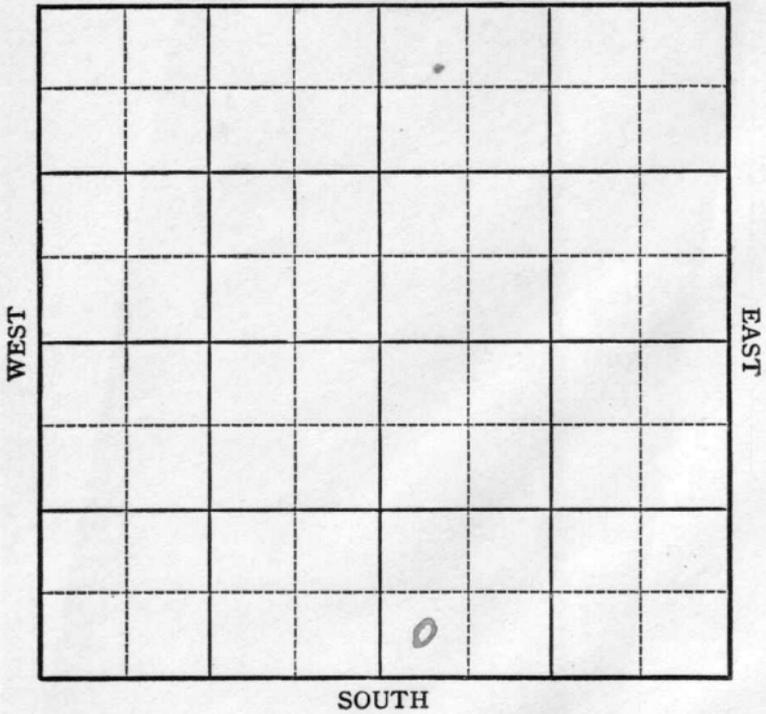

Sec. 1 Twp. 23 R. 19-W

Well No. #1 Boyd Farm

Stanolind Company

(Wildcat)


_____ Ft. from N. Line

330 Ft. from S. Line

_____ Ft. from E. Line

330 Ft. from W. Line

Elev. 2166

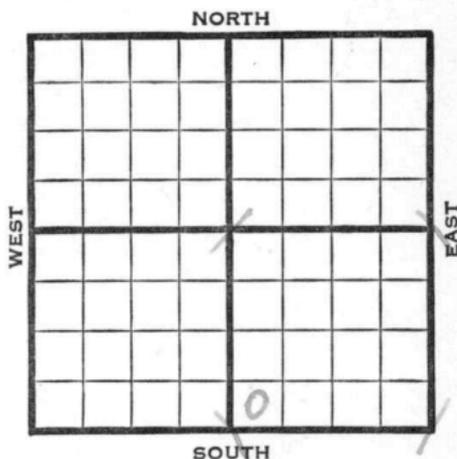

REPORT

1942

5/13

Derrick.

5/20

8" - 613' Anhy. 1283'

Drlg. 1450'

5/27

Drlg. 3375'

6/3

Dodge 3840' Lans. 3871'

Drlg. 4063'

6/10

B.K.C. 4175' Cong. 4408'

Coring 4642'

6/17

Arb. 4971'

T.D. 5035'

No shows.

ABANDONED

Edwards

KANSAS

Map No. 85 Sec. 1 Twp. 23 R. 19W

Well No. 1 Boyd

Stanolind


Company

FIRST REPORT

Contractor

SW SE

SECTION PLAT

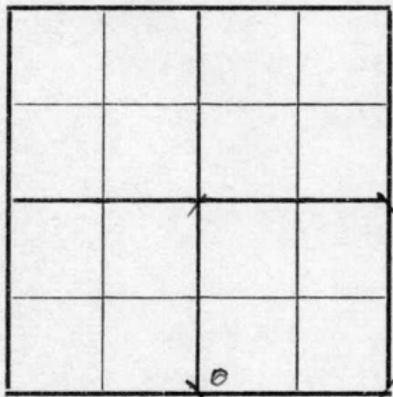

_____ Ft. from N. Line

330 Ft. from S. Line

_____ Ft. from E. Line

330 Ft. from W. Line

WILDCAT

RECORD

Location _____

Cased _____ in., _____ ft.

Rig up _____

Sand _____

Drilling and Remarks:

Gas _____

Oil _____

Derrick

Total Depth _____

PRODUCTION

1st 24 hrs. Nat. _____

1st 24 hrs. after shot _____

Gas _____ Cu. Ft.

Dry Hole _____

Abandoned _____

Date

MAY 13 1942

19

S. J. LEWIS

Scout

Edwards KANSAS

Map No. 85- Sec. 1 Twp. 23 R. 19W

Well No. 1 Boyd

Stanolind Company

ABANDONED Contractor

SWSE

SECTION PLAT

_____ Ft. from N. Line

330 Ft. from S. Line

_____ Ft. from E. Line

330 Ft. from W. Line

WILDCAT

RECORD

Location _____

Cased _____ in., _____ ft.

Rig up _____

Sand _____

Drilling and Remarks:

Gas _____

Oil _____

Total Depth 5035

Cu # 4971

Noshows

PRODUCTION

1st 24 hrs. Nat. _____

1st 24 hrs. after shot _____

Gas _____ Cu. Ft.

Dry Hole _____

Abandoned _____

Date

JUN 17 1942 19 _____

S. J. LEWIS Scout