


Section 1 Township 23 Range 33 WWell No. # 1 SoobyCompany Northern Pump

NORTH

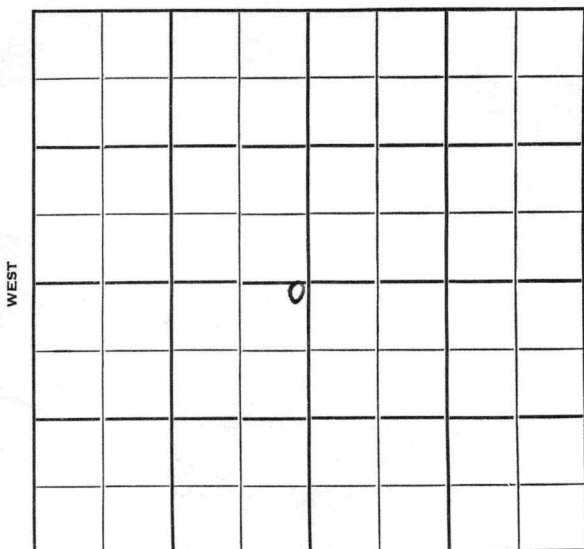

SOUTH

Finney

KANSAS

Sec. 1 Twp. 23 R. 33W

Well No. #1 Sooby Farm

Northern Pump Company

Contractor

Hugoton Pool


150 Ft. from N. Line

_____ Ft. from S. Line

150 Ft. from E. Line

_____ Ft. from W. Line

NE NE SW

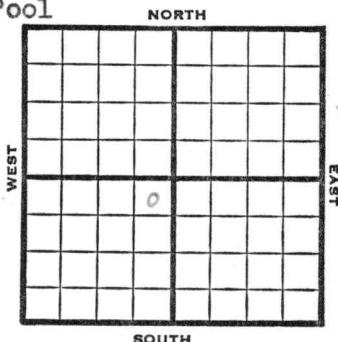


1953 Elev. 2873' REPORT

6/3 M I R

6/10 10" @ 333 RTD 2608' 7" @ 2598
Schl tops: Her 2536 Kr 2556
Win 2596'

6/24 CO 2598, 3½ M
PB 2591, 5/2583- sq 3000 dol
CO 2608, 2000A, 500 dol
15/2599-2604, 60/2538-48, 96/2560-76

7/1 Spud 62-53
Gas Well
TD 2608
10" @ 333
Her 2536, Kri 2556, Win 2596
TD 2608
7" @ 2598
CO to 2598 3½ mcfg
PB 2591, 5/2583, 3000 dol-frac
CO to 2608, 2000A
500 dol-frac
15/2599-2604, 60/2538-48, 96/2560-76
Comp. 9 mcfgpd 438#

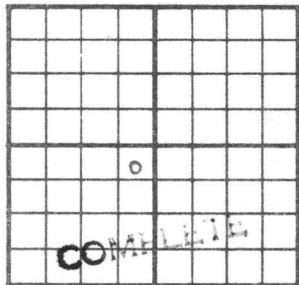County Finney State KansasSec. 1 (Blk.
Twp.) 23 (Sur.
Rge.) 33W Map No.Operator Northern PumpWell No. 1 Farm SoobyElev. 2873 Location NE NE SW150 Ft. From N Line SW150 Ft. From E Line Quarter1st. ReportCompletion JUL 1 1953Remarks Hugoton PoolSpudding Date 6-2-53Drlg. Data Gas well TD 260810" @ 333 Her. 2536 Kri. 2556Win. 2596 TD 2608 7" @ 2598CO to 2598 $3\frac{1}{2}$ mcf/g PB 25915/ 2583 3000 dol-frac CO to 26082000 A 500 dol-frac 15/ 2599-260460/ 2538-48 96/ 2560-76Comp. 9 mcf/gpd 438#