





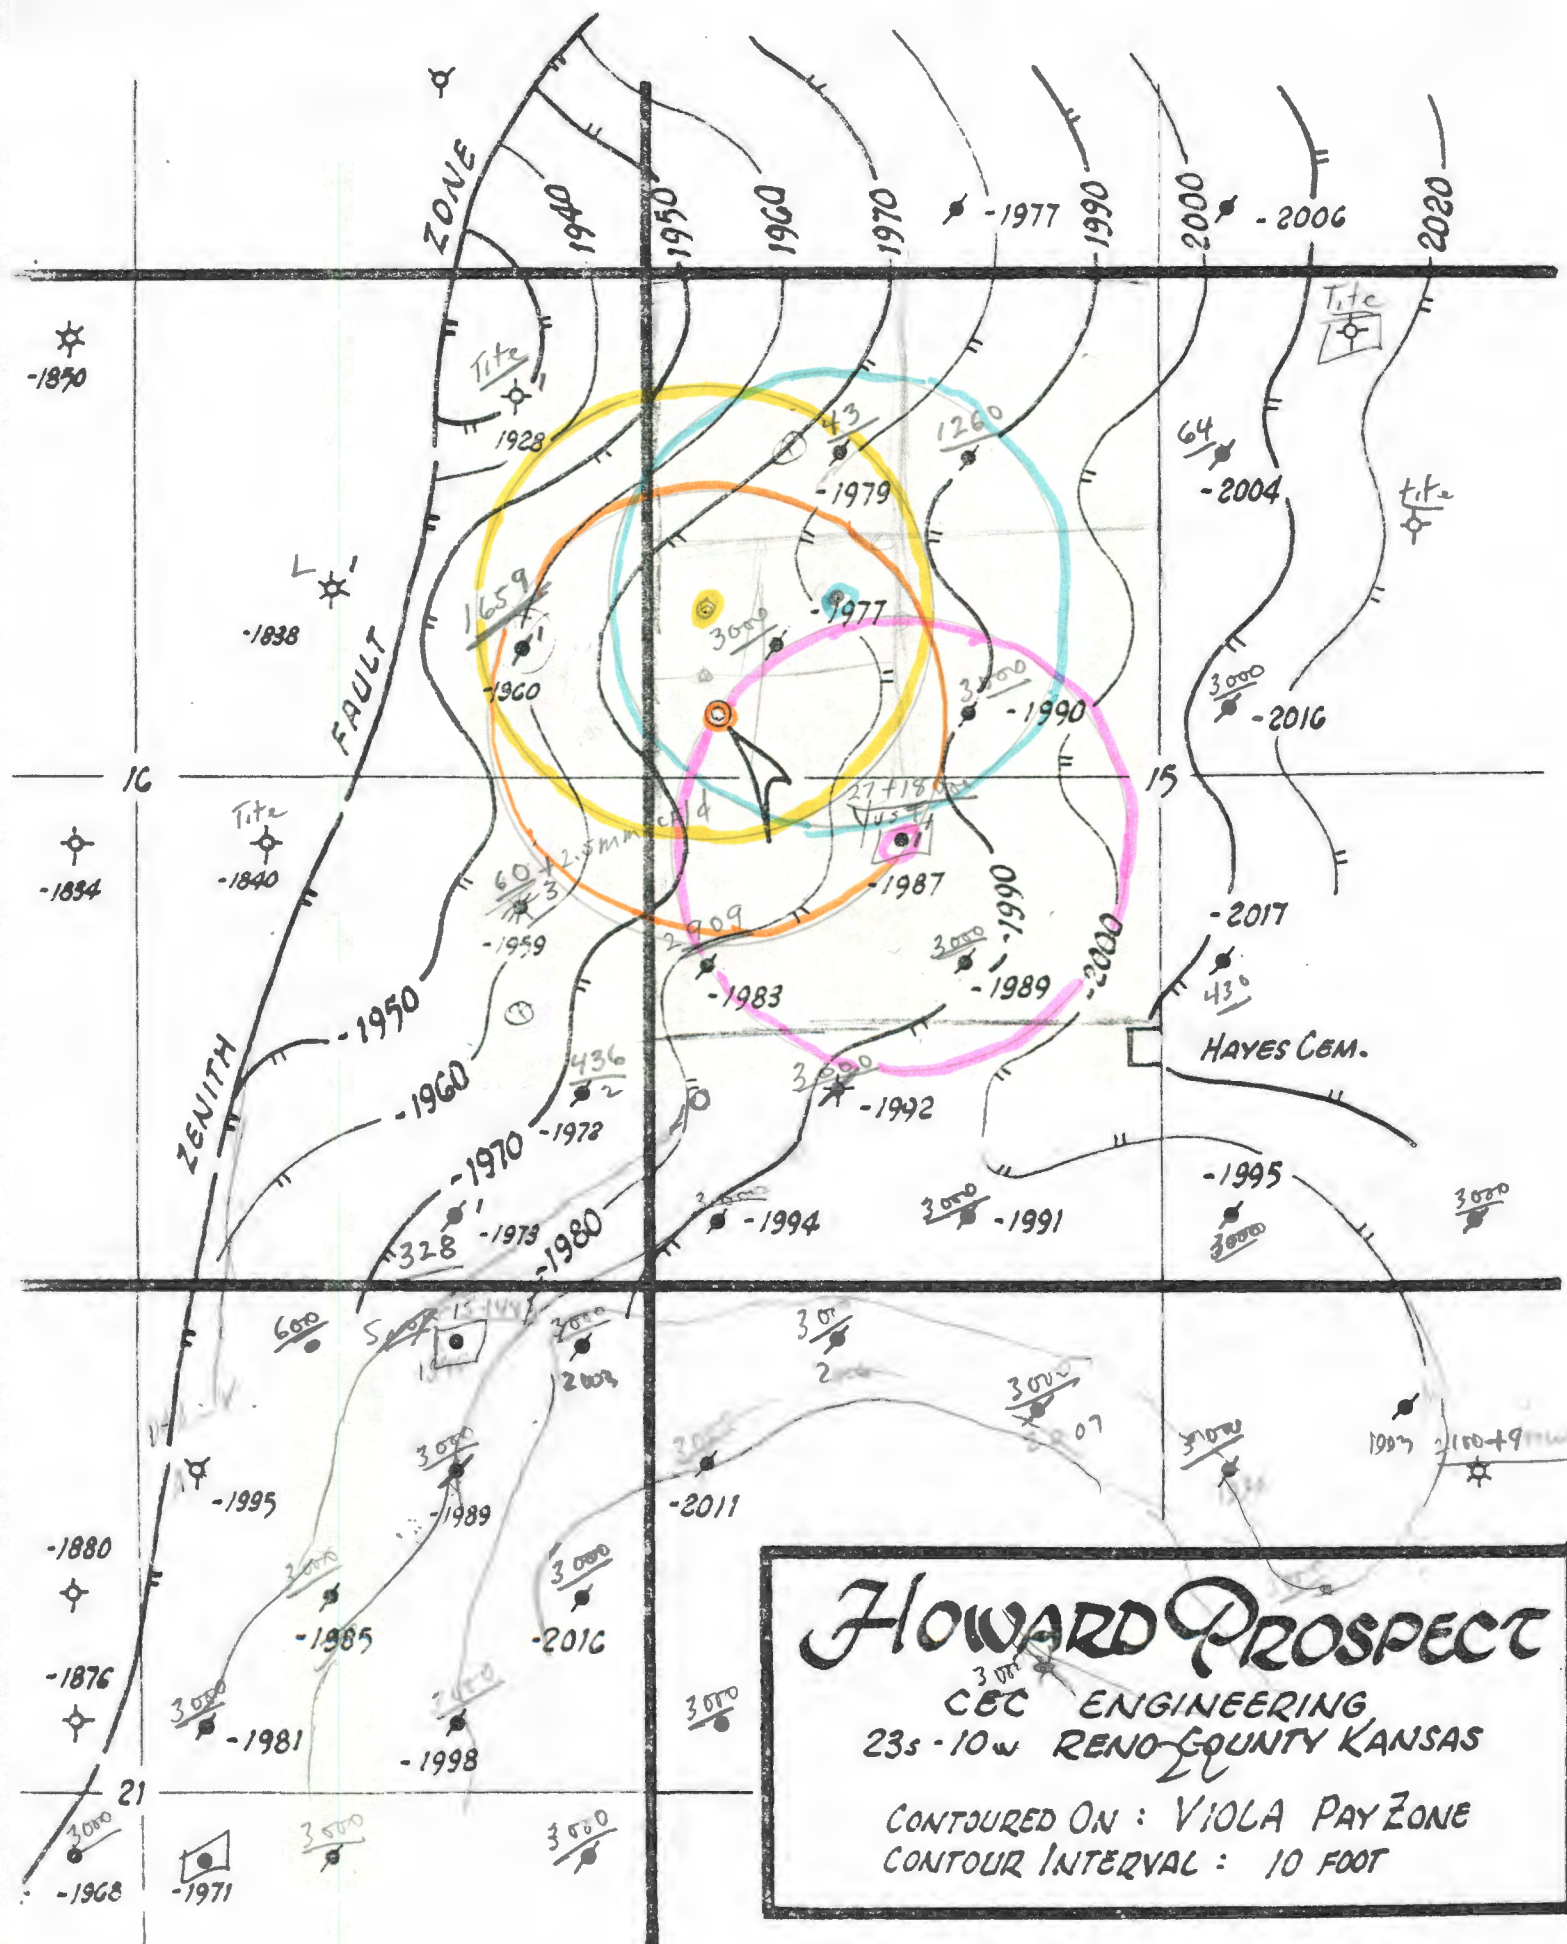

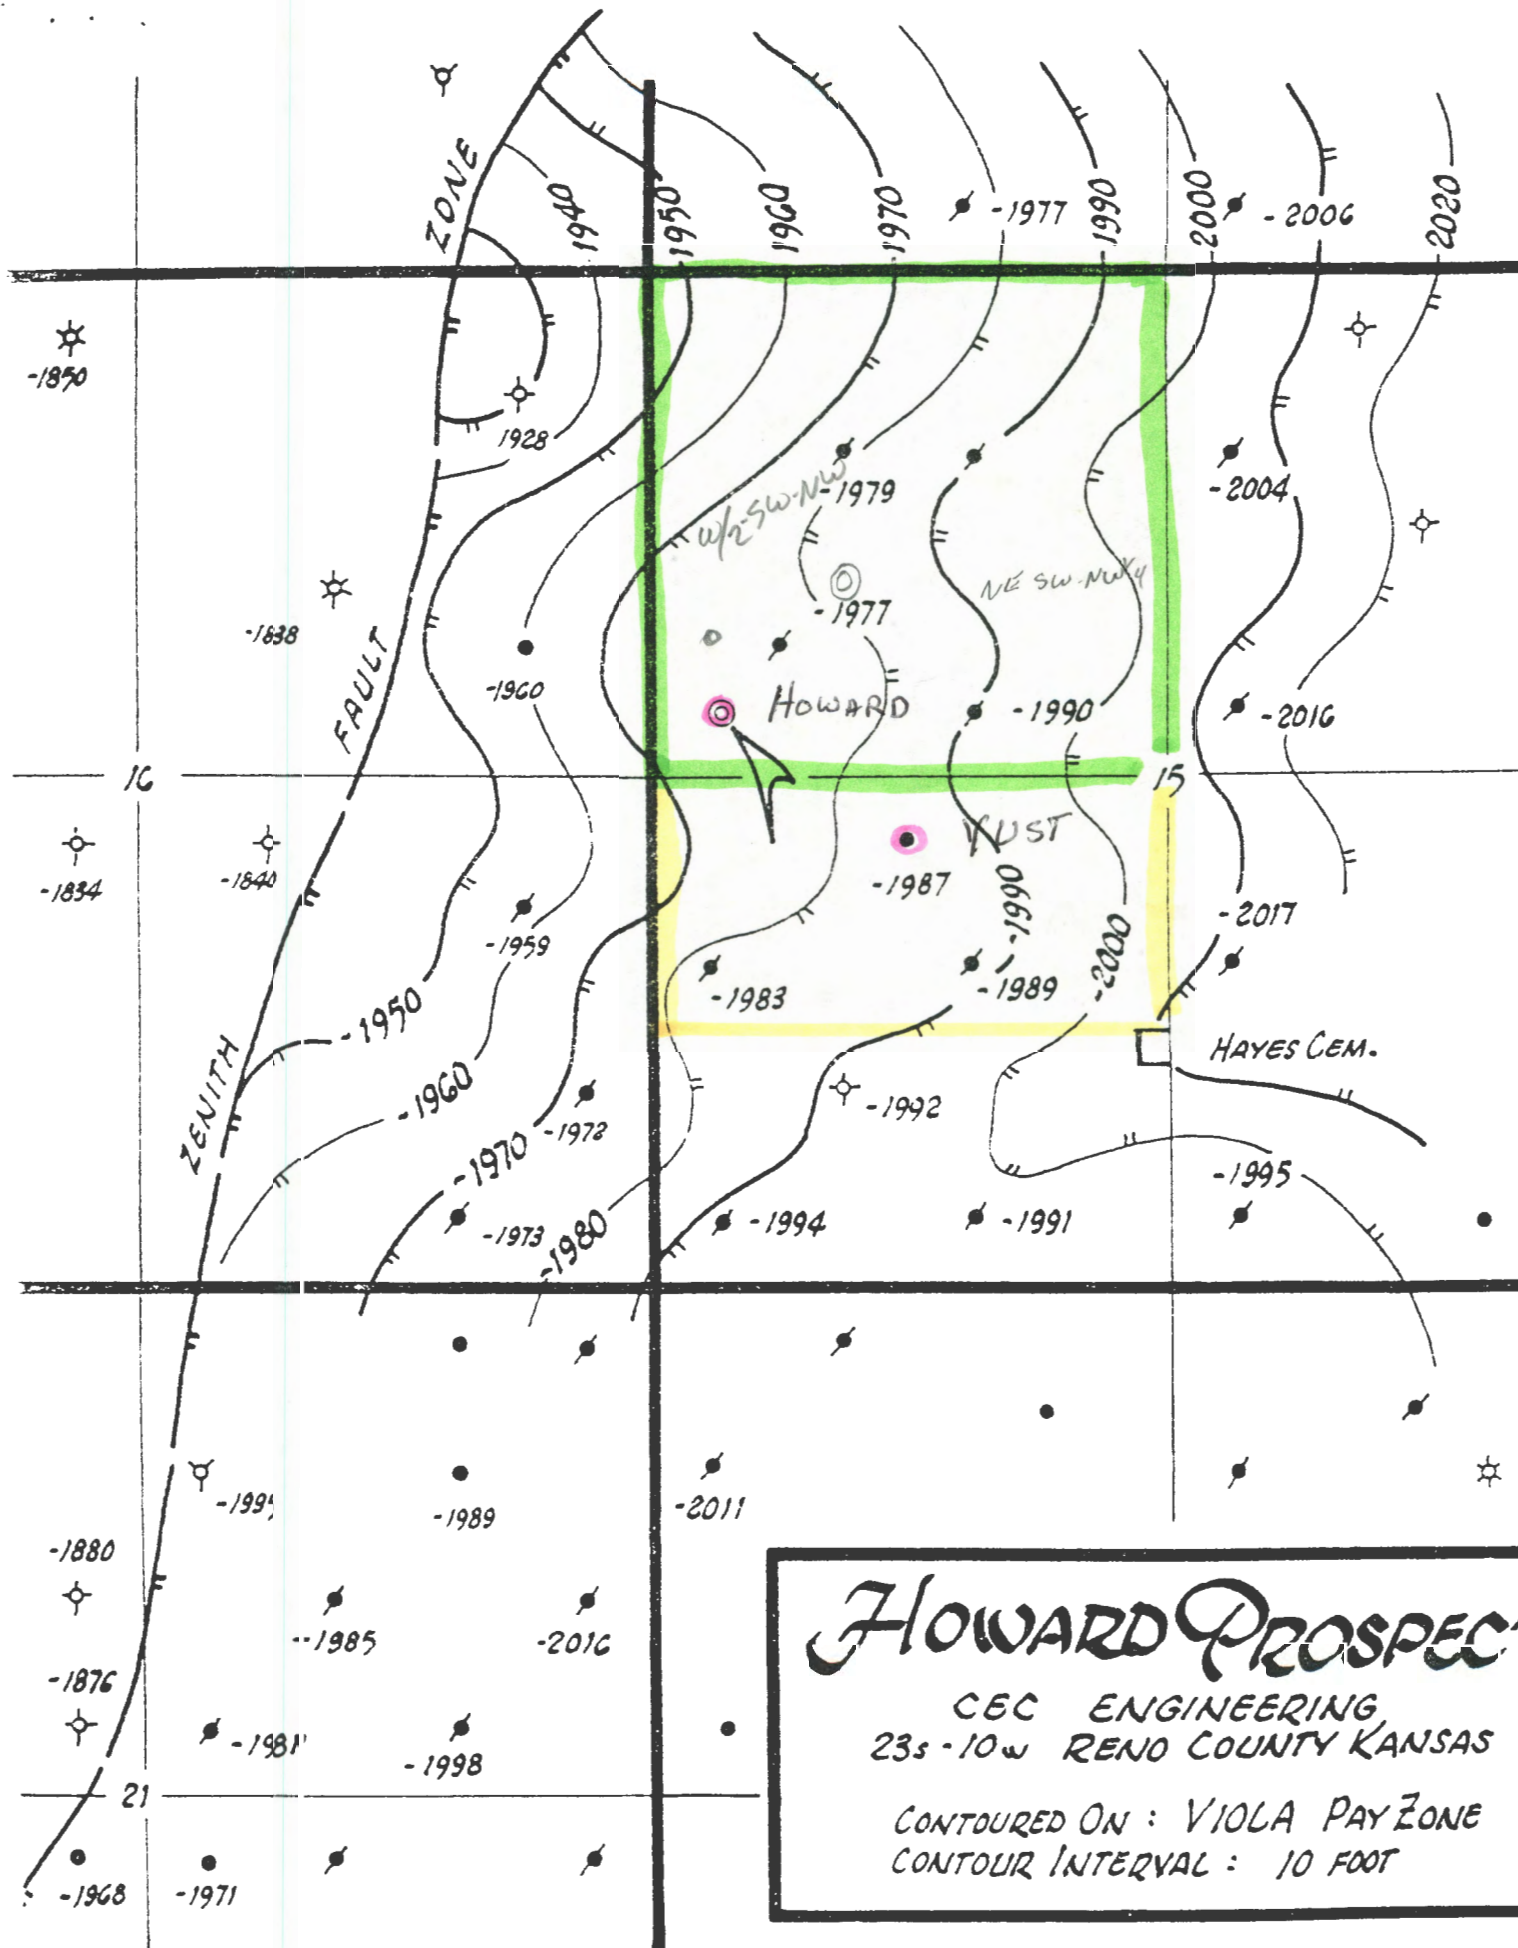

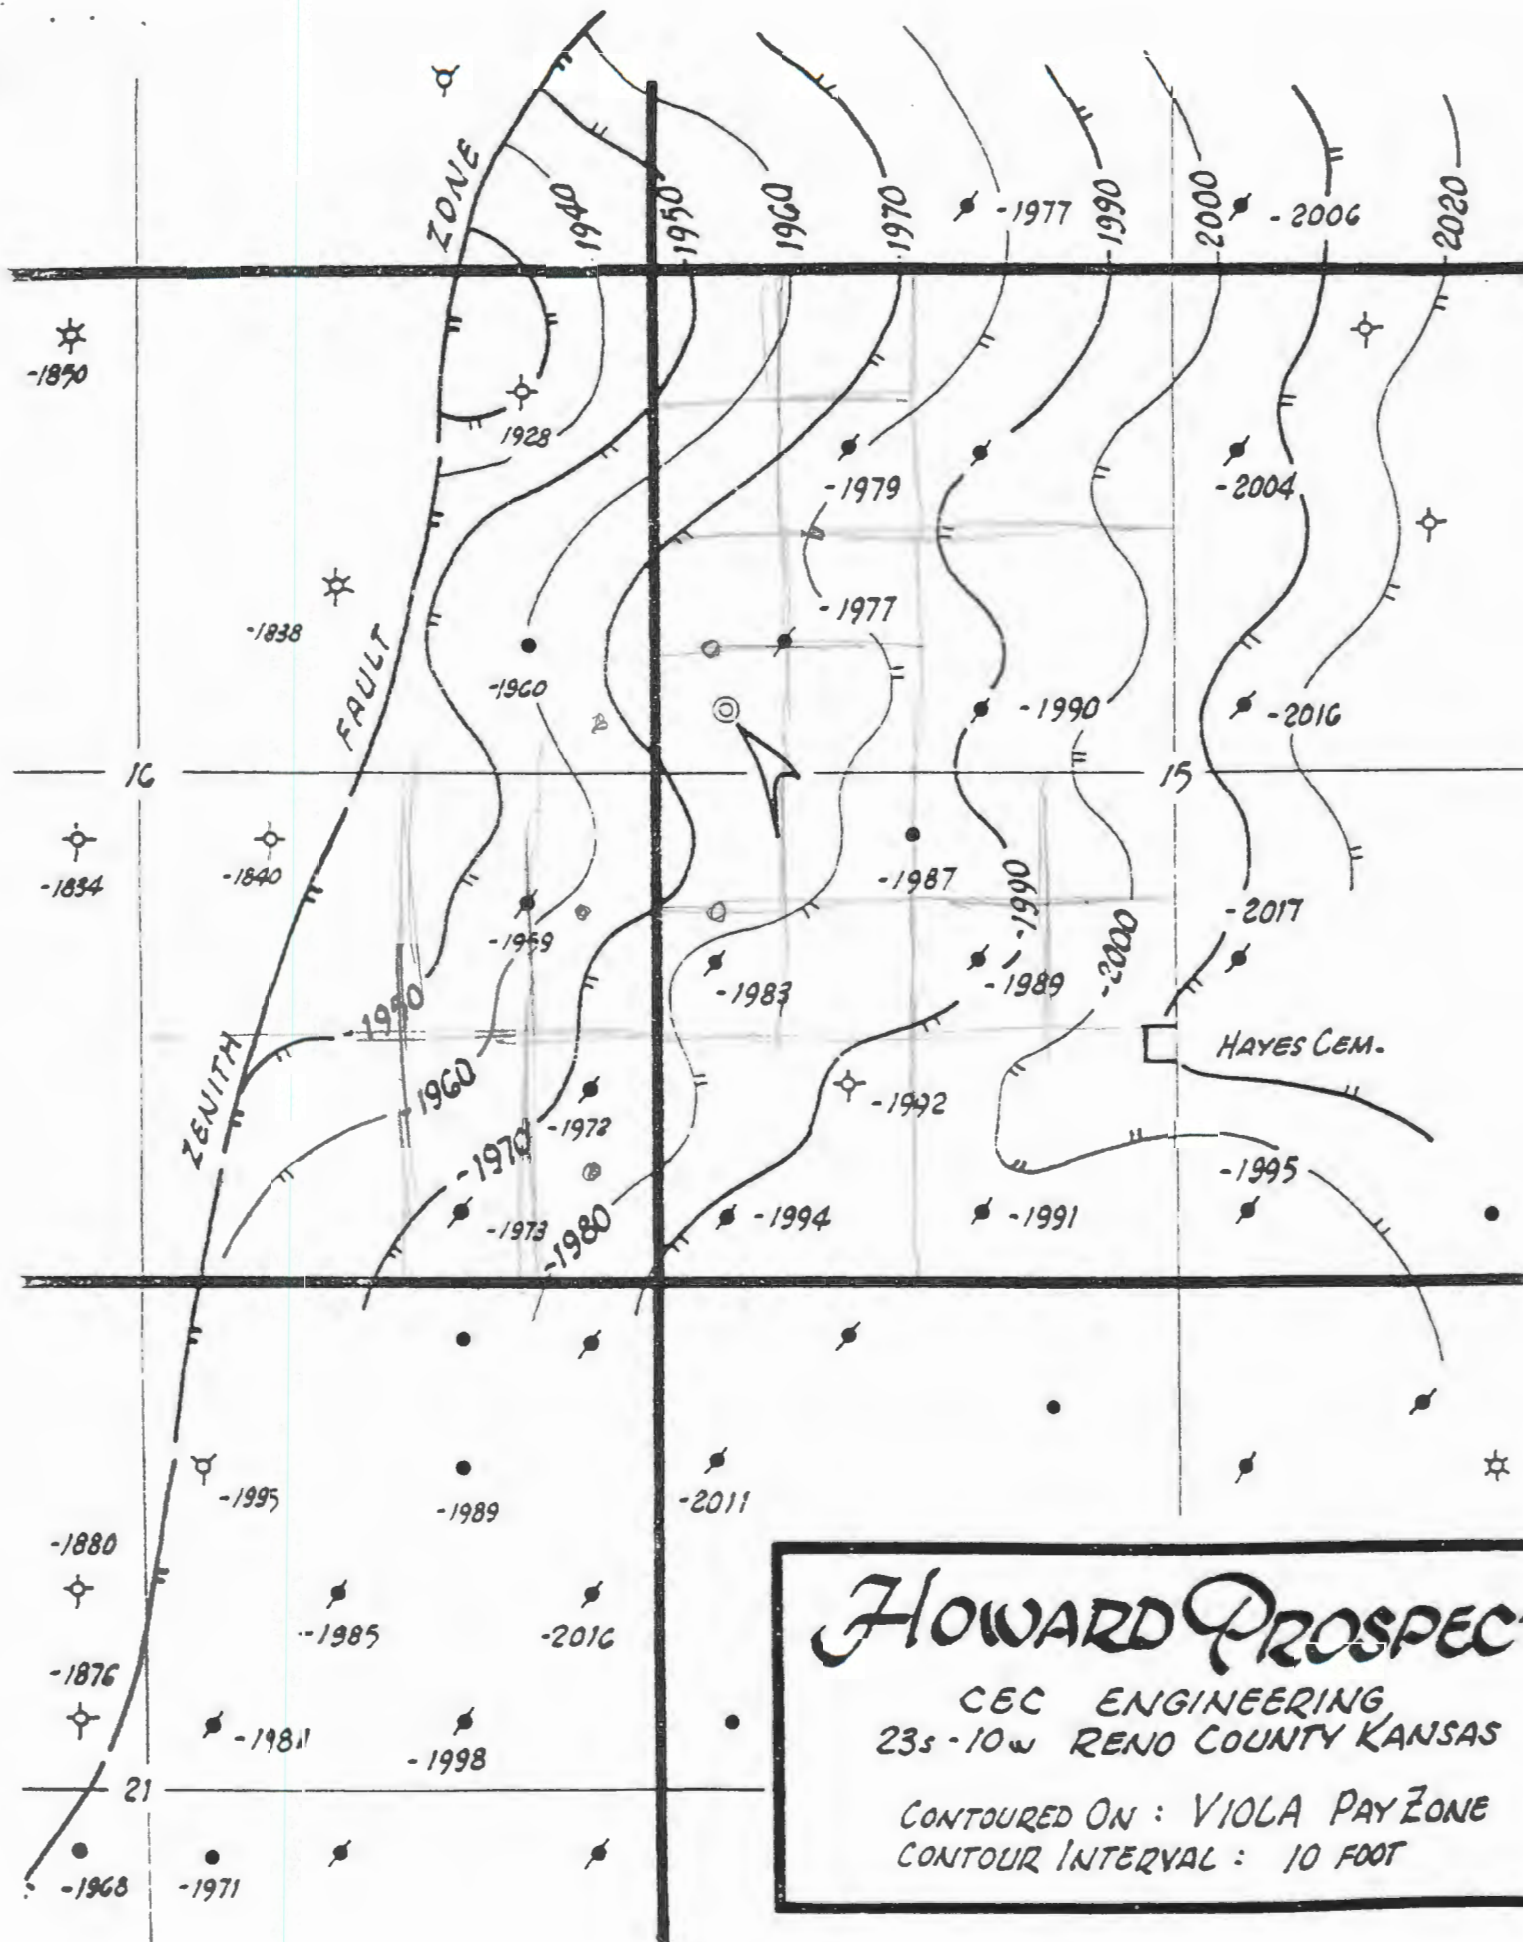


[illegible]

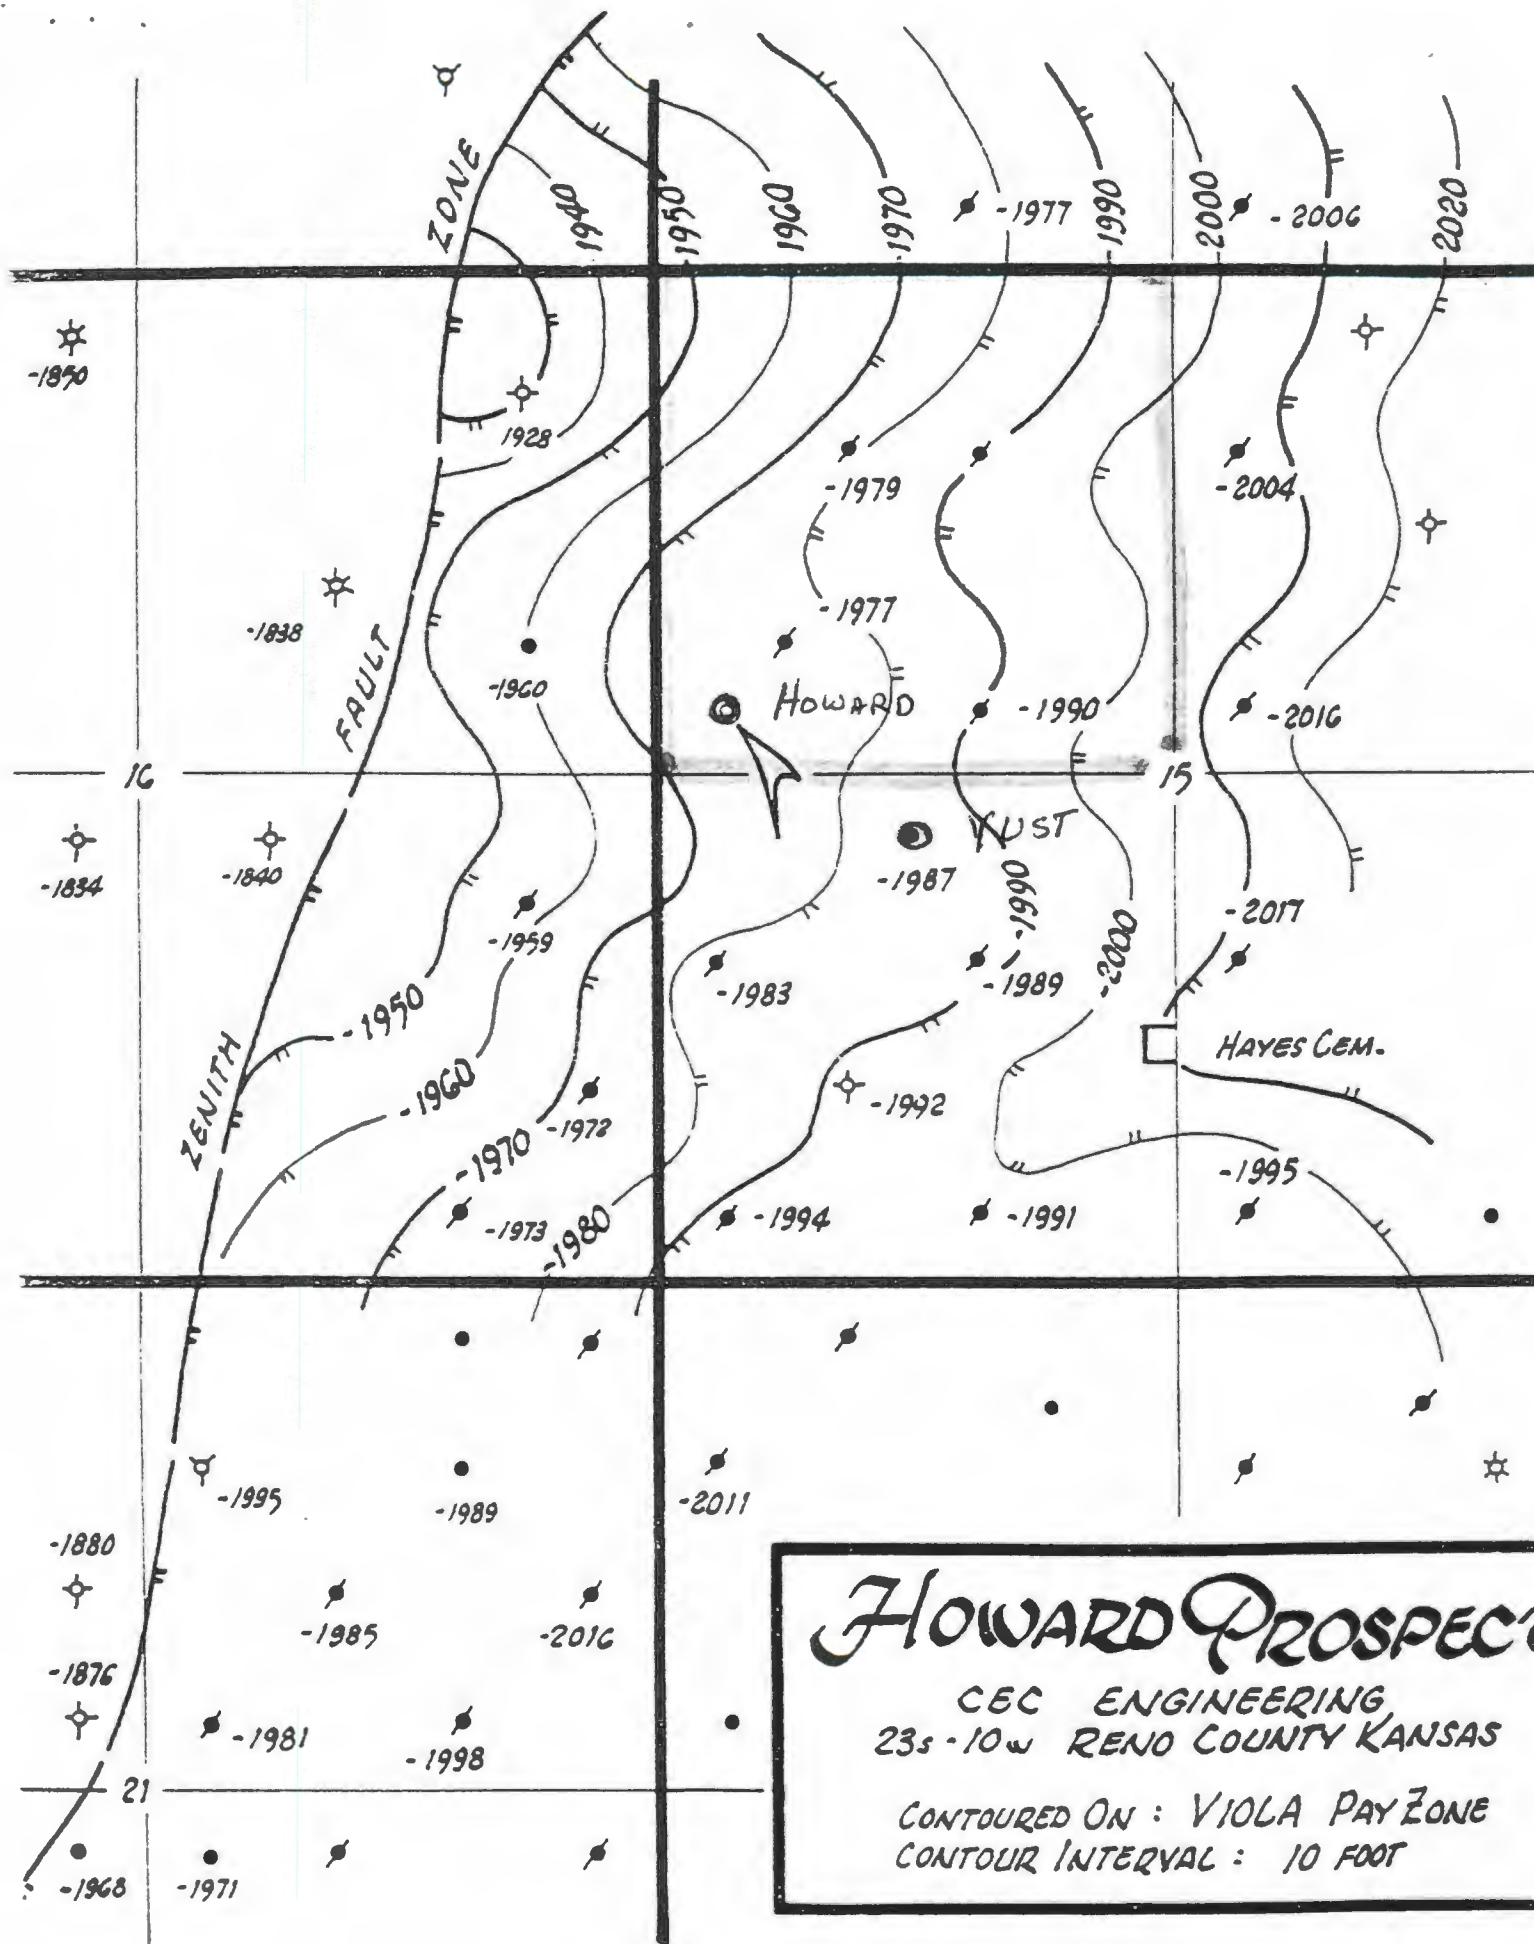


HOWARD PROSPECT

CEC ENGINEERING
23s - 10w RENO COUNTY KANSAS

CONTOURED ON : VIOLA PAY ZONE
CONTOUR INTERVAL : 10 FOOT

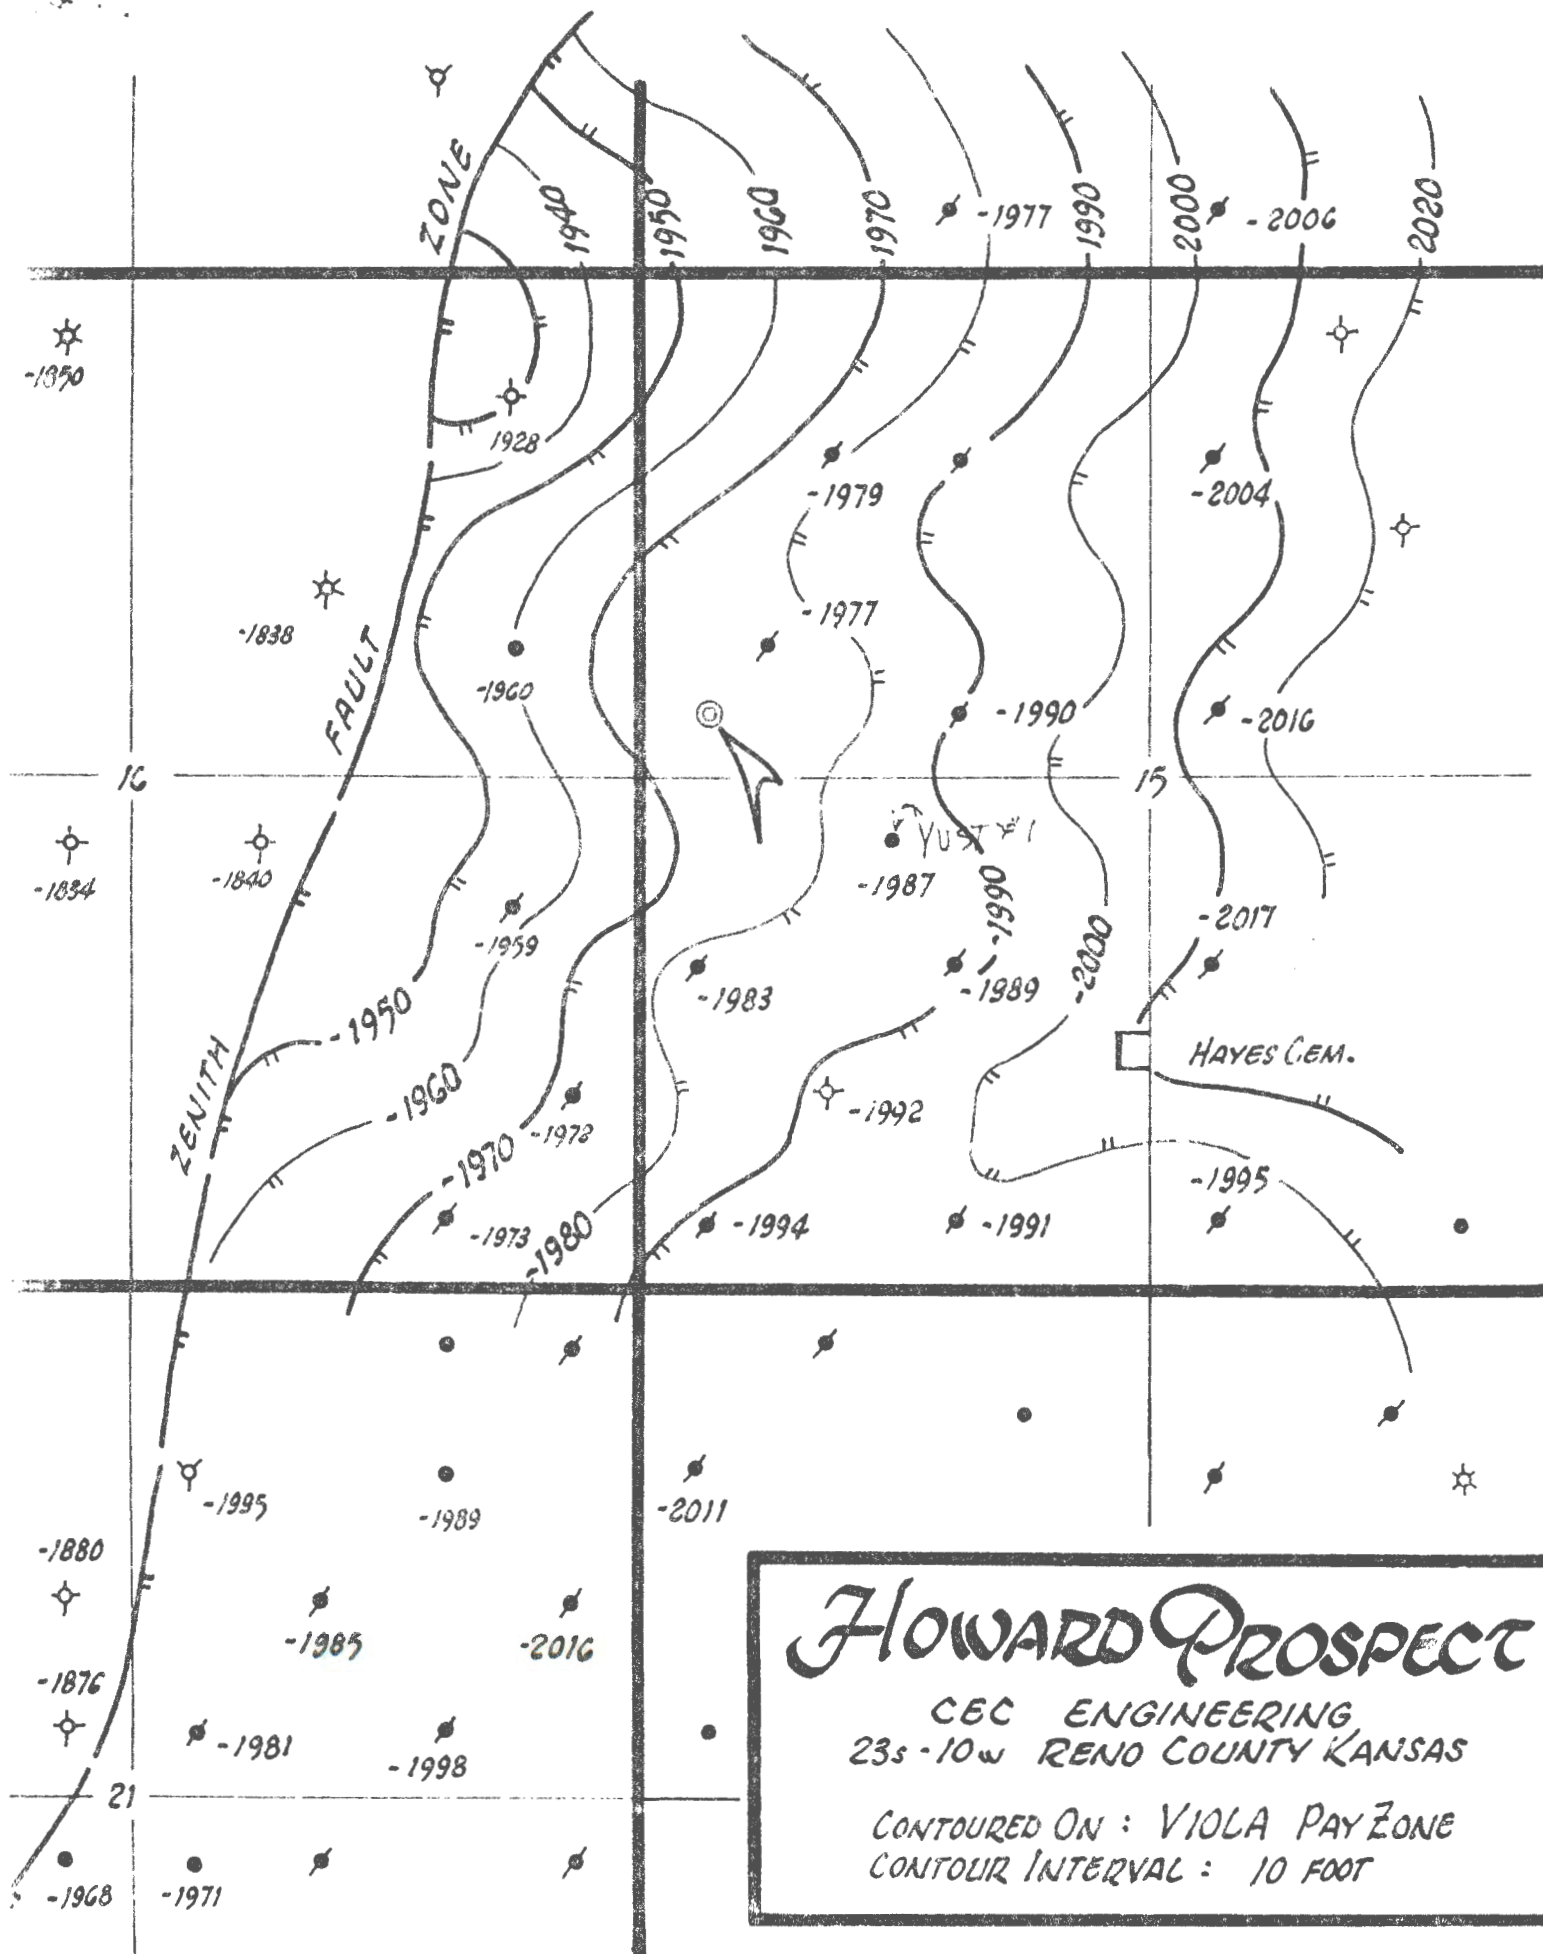


[illegible]

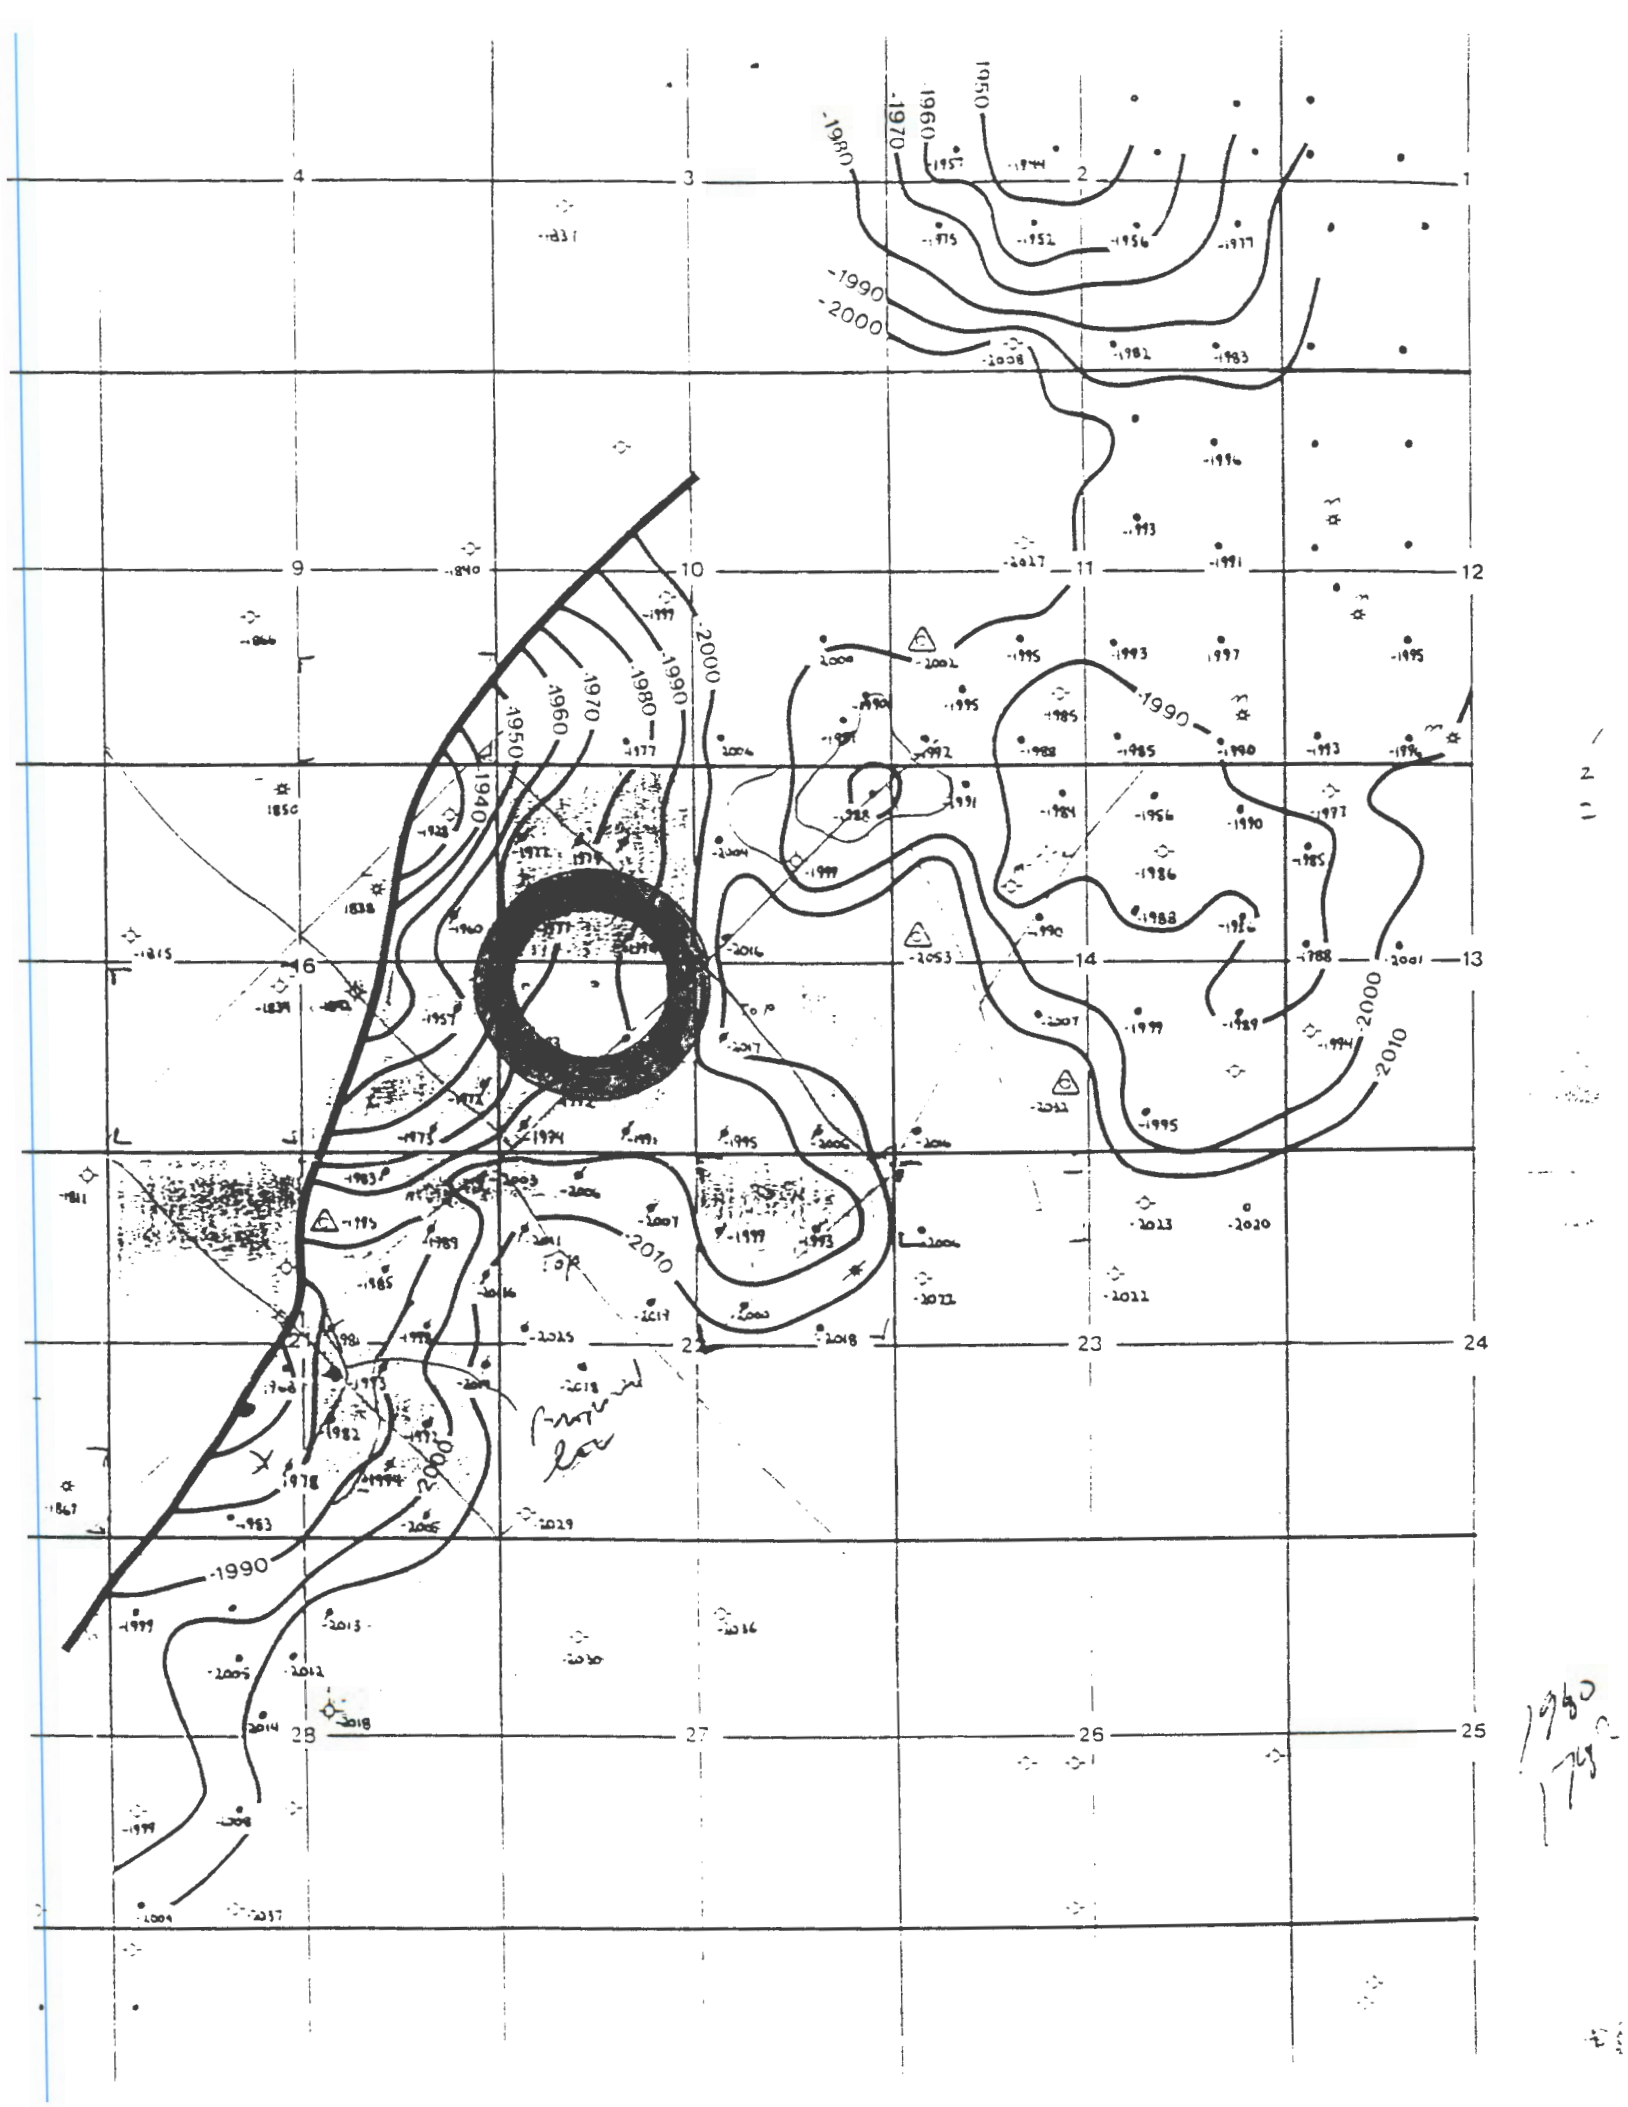

H. E. Ornd etal	Hurst	Wallace O Yust	Anker- holz	Kees ling	Sara & Alan Fair	Sankey	Nina Fair	Frank C. C J. C. Smisor	
0									

Township 23 S, Range 10 W, County Reno, State Kansas

Howard Prospect

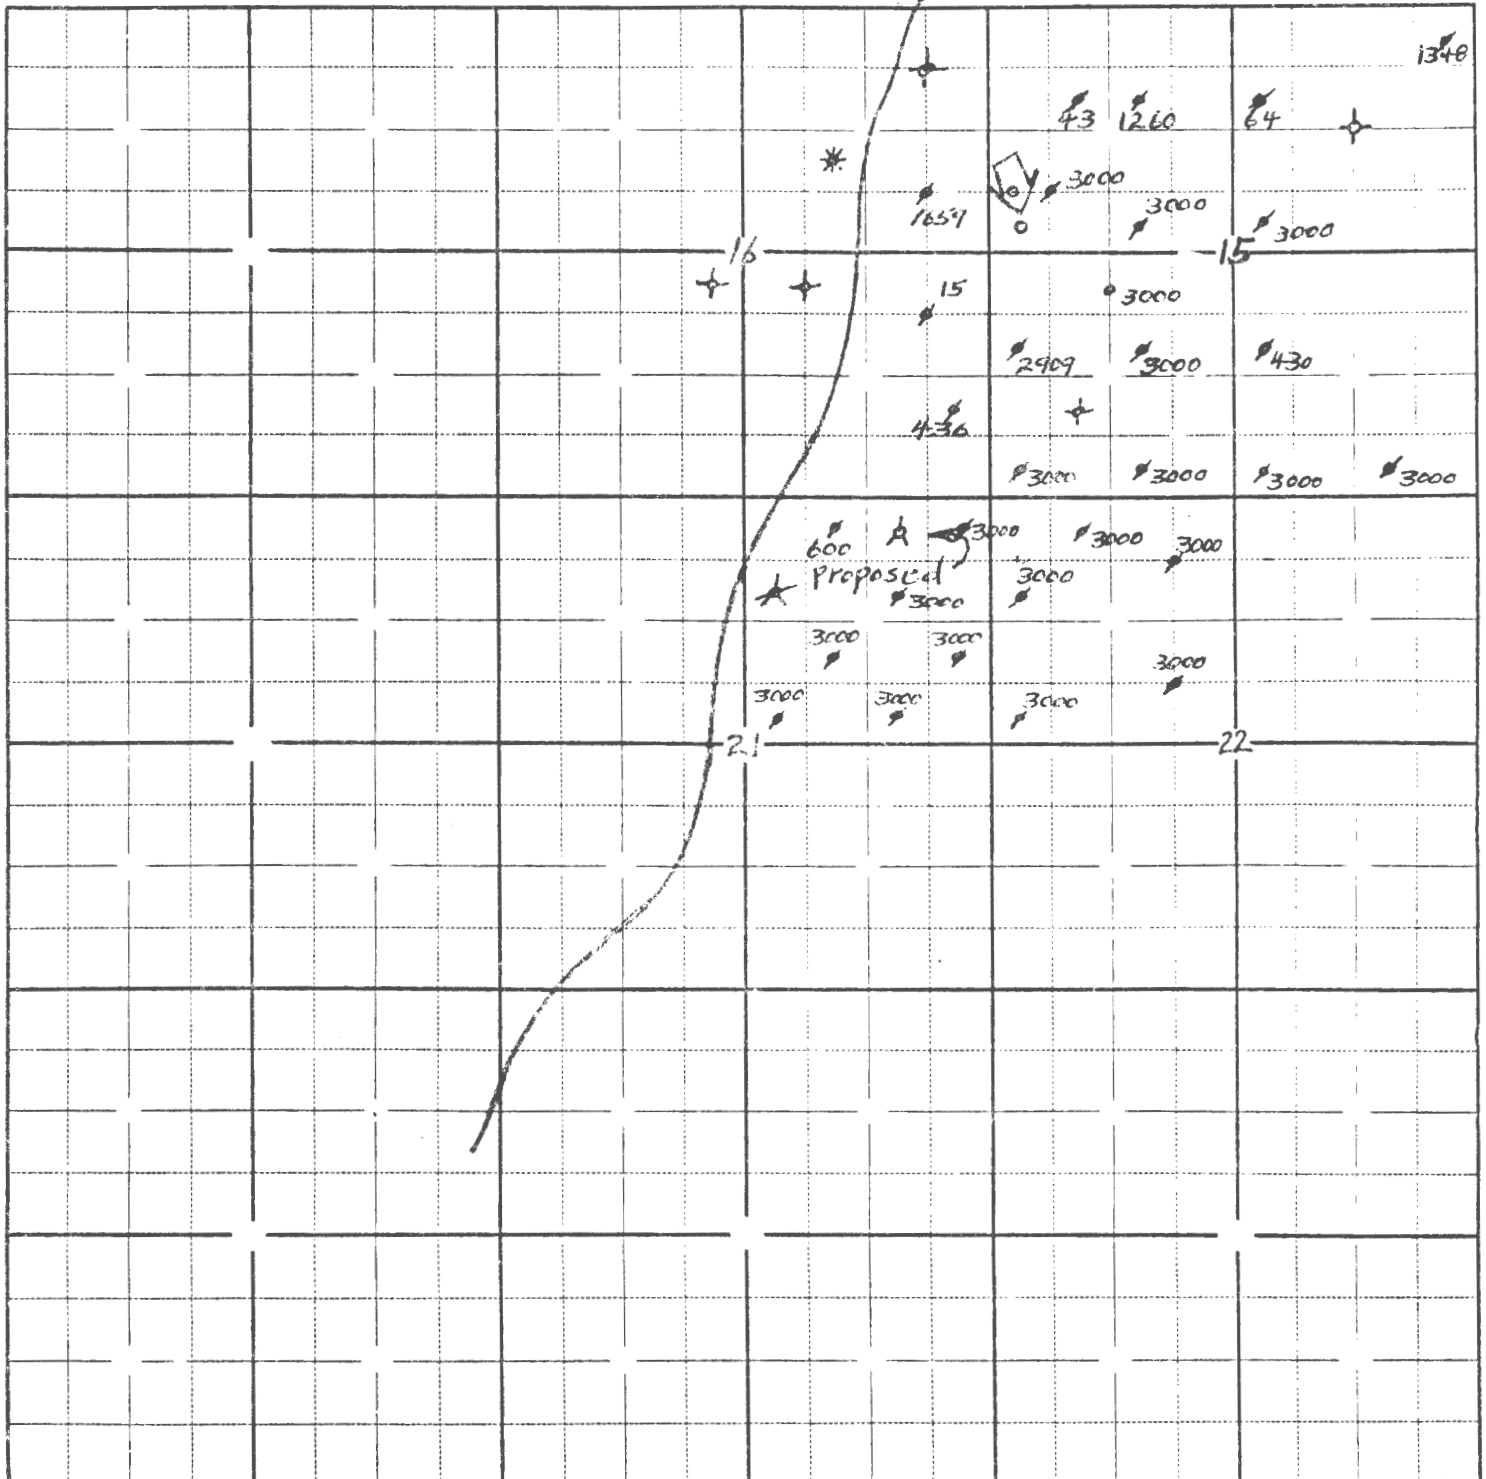

3000
• Viola Potential, BOPD

FORM 53