

Harvey


KANSAS

SECTION 10 TOWNSHIP 23 RANGE 2W

WELL NO. #1 Lehmyer Ruth

COMPANY C.L. Carlock

NORTH

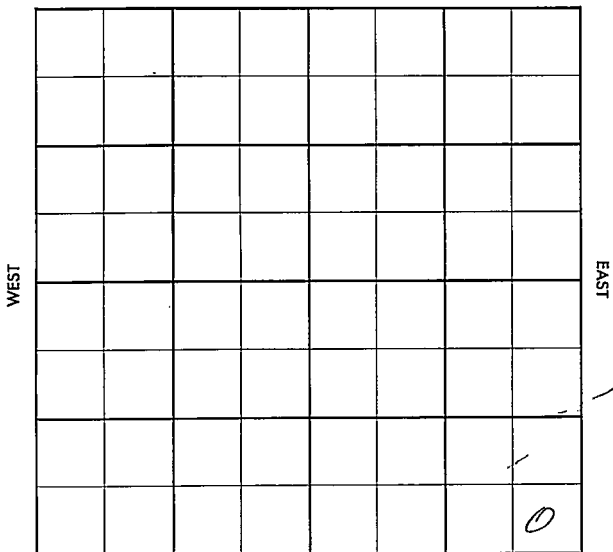

SOUTH

CORRECTION

FORM 513 REV. SUNRAY

County Harvey Elev. _____
 Sec. 10 Twp. 23 Rge. 2W
 Company C. L. Carlock
 Farm Name Ruth No. 1

TOPS	DEPTH	LOG	DATUM	Loc. in Sec.
Anb.				SE SE SE
Tr.				
H.				
Dg.				
Bl.				
L.				Geol. _____
K.C.				Contr. _____
B.K.C.				
Ce.				
C.				
M.				
M.				Pool _____
K.				
Mz.				
Mq.				
V.				
S.				
S.				
A.				
R.				
Pe.				
G.				
T.D.				

CORRECTION


Date Comm. MAY 2 1956
Reported #1 Lohmeyer

Co.
Lse.
No.
Sec.
T.
R.

County Harvey Elev. 1429
 Sec. 10 Twp. 23 Rge. 2W
 Company C. L. Garlock
 Farm Name Ruth No. 1

TOPS	DEPTH	LOG	DATUM
Anh.			
Tr.			
H.			
Dg.			
Bl.	<u>2274</u>		<u>845</u>
L.	<u>2334</u>		<u>905</u>
K.C.	<u>2543</u>		<u>1114</u>
B.K.C.	<u>2729</u>		<u>1300</u>
Ce.			
C.			
M. <u>Chat</u>	<u>2943</u>		<u>1314</u>
M. <u>Chart</u>	<u>2977</u>		<u>1548</u>
K.			
Mz.			
Me.			
V.			
S.			
S.			
A.			
R.			
PE.			
G.			
T.B.	<u>2987</u>		

Loc. in Sec. SE SE SE
 Geol. _____
 Contr. _____
 Pool _____
Halstead

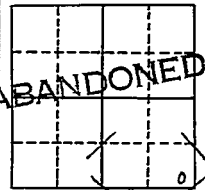

Date Comm. 4-12-56 MAY 2 1956
8 5/8" @ 157/130 DST 2945-67 open 1 hr.
rec. 31' vso & gcm 50/20" DST 2978-87
open 1 1/2 hr. rec. 3' free oil 27' wocm
90' sw 875/20"

D & A