

FORM 51 5M 10-41 PETROL

Company Leader Oil

EAST


SOUTH

Sec. 10 Twp. 23 R. 10-WWell No. #3 McMurray FarmLeader Oil Company

(Peace Creek)

990 Ft. from N. Line Ft. from S. Line990 Ft. from E. Line Ft. from W. Line

Elev. 1772

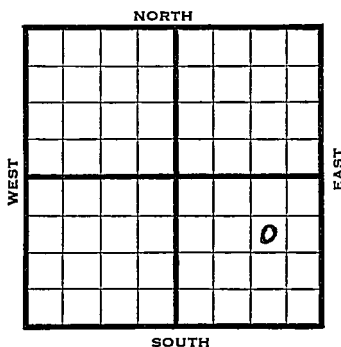

1942

REPORT

7/1 Bldg. rotary Derrick.
7/15 10" - 300' Drlg. 2625'
7/22 Drlg. 3305'
7/29 Viola 3773' T.D. 3775'
5" - 3775 RUST
8/5 T.D. 3786
Pump $7\frac{1}{2}$ oil per hr 72 hrs.
8/12 Viola 3773 5" - 3775
T.D. 3786
Pump 61 Pot.
Gravity 42.

COMPLETED

Reno

KANSAS

Map No. 47 Sec. 10 Twp. 23 R. 10WWell No. 3 McMurrayLeader Oil CompanyFIRST REPORT Contractor

SW NE SE

990 Ft. from N. Line Ft. from S. Line990 Ft. from E. Line Ft. from W. Line

SECTION PLAT

			o

Peace Creek Pool

Location Rig up

Drilling and Remarks:

Bldg. Rotary
Derrick

RECORD

Cased in., ft.Sand Gas Oil Total Depth

PRODUCTION

1st 24 hrs. Nat. 1st 24 hrs. after shot Gas Cu. Ft.Dry Hole Abandoned

Date

JUL 1 1942 19S. J. LEWIS

Scout

Map No. 47 Sec. 10 Twp. 23 R. 10WWell No. 3 McMurrayLeader Oil CompanyCOMPLETE Contractor

SW NE SE

990 Ft. from N. Line Ft. from S. Line990 Ft. from E. Line Ft. from W. Line

PEACE CREEK POOL

SECTION PLAT

			o

Location Rig up Drilling and Remarks: *Viola 8773**5" @ 8775**Pump 61 P28**42° Gr*

RECORD

Cased in., ft.Sand Gas Oil Total Depth 3286

PRODUCTION

1st 24 hrs. Nat. 1st 24 hrs. after shot Gas Cu. Ft.Dry Hole Abandoned

Date

AUG 12 1942

19

S. J. LEWIS Scout