

KANSAS


Stafford

FORM 51 IOM 12-46 PETROL

Section 10 Township 23 Range 13W

Well No. 1 Garvin

Company Magnolia

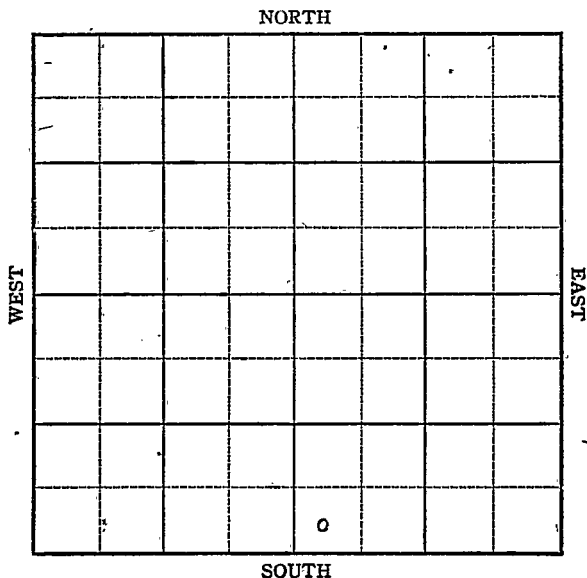

KANSAS

Stafford

Sec. 10 Twp. 23 R. 13 W ✓

Well No. #1 Garvin Farm


Magnolia Company

 Ft. from N. Line

330 Ft. from S. Line

 Ft. from E. Line

330 Ft. from W. Line

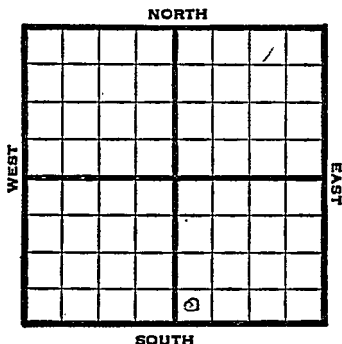

SW SE - - -

1947 Elev. 1870'

REPORT

4/23 Location

4/29 8" @ 260
Drlg 1615'

5/7 Drlg. 3270'

5/14 Arb. 3850'
TD 3870'

ABANDONED

Map No. 183 Sec. 10 Twp. 23 R. 13W

Well No. 1 Garvin

Magnolia Company

FIRST REPORT Contractor

SW SE


SECTION PLAT

 Ft. from N. Line

330 Ft. from S. Line

 Ft. from E. Line

330 Ft. from W. Line

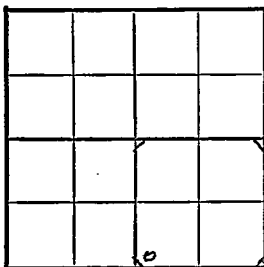

Stafford County

Location X

Rig up

Drilling and Remarks:

RECORD

Cased in., ft.

Sand

Gas

Oil

Total Depth

PRODUCTION

1st 24 hrs. Nat.

1st 24 hrs. after shot

Gas Cu. Ft.

Dry Hole

Abandoned

Date

APR 23 1947 19 S. J. LEWIS Scout

Kansas

Wildcat Pool


Map No. K83 Sec. 10 Twp. 23 R. 13WWell No. 1 GarvinMagnolia

Company

ABANDONED

Contractor

SW SE

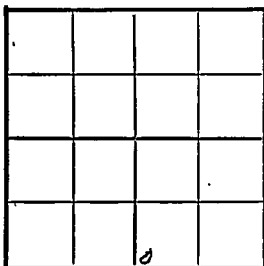E 1, 1870
SECTION PLAT Ft. from N. Line330 Ft. from S. Line Ft. from E. Line330 Ft. from W. LineStafford CountyLocation Rig up

Drilling and Remarks:

Per 13850**RECORD**Cased in., ft.Sand Gas Oil Total Depth 8870**PRODUCTION**1st 24 hrs. Nat. 1st 24 hrs. after shot Gas Cu. Ft.Dry Hole Abandoned

Date

MAY 14 1947

19

S. J. LEWIS

Scout