


Section 10 Township 23 Range 17 W

Well No. #1 Anderson

Company Colorado Oil & Gas

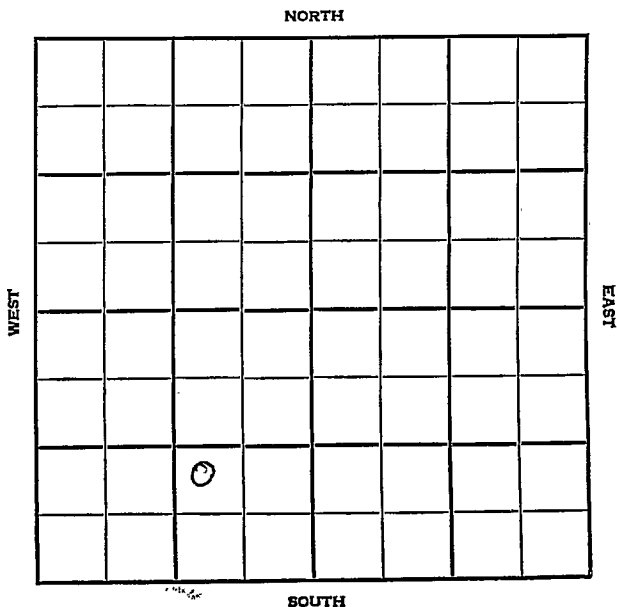

Pawnee

KANSAS

SEC. 10	TWP. 23	R. 17W
------------	------------	-----------

WELL NO. #4 Anderson FARM

COMPANY Colorado Oil & Gas

CONTRACTOR Honaker


Garfield

_____ Ft. from N. Line

880 Ft. from S. Line

_____ Ft. from E. Line

1320 Ft. from W. Line

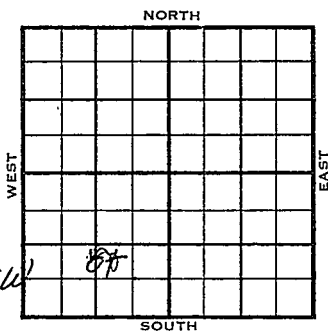

1956	ELEVATION	REPORT
	2097	

2-8 MIR

3/28 Comm 2-7-56

Anh	1135
H	3666
B1	3780
L	3787
Shale	4201
Cg Chert	4218
TD	4360

8 5/8" @ 237/175

5 1/2" @ 4359

CO 32/4274-83 500 A PB 4270

40/4256-66 SP 4238 S/1 boph 4 hr

500 A frac S/4.22 boph 4 hr

~~500~~ 500 A S/7.38 boph 13 hr frac

11 boph 11 hr CO to 4266

Comp 95 bopd 8% wtr

COMPLETED

County Pattee Elev. _____
 Sec. 10 Twp. 23 Rge. 17W
 Company Colorado Oil & Gas
 Farm Name Anderson No. 4

TOPS	DEPTH	LOG	DATUM
Anh.			
Tp.			
H.			
Tr.			
Dg.			
Bl.			
L.			
K.C.			
B.K.C.			
Ce.			
C.			
M.			
M.			
K.			
Mz.			
Ma.			
V.			
S.			
S.			
A.			
R.			
PE.			
G.			
T.D.			

Loc. in Sec. _____
NW SE SW
880' SL
1320' WL

Geol. _____
 Contr. Honaker

Pool Garfield

FIRST REPORT
 FEB 8 '56

Date Comm. MIR

[Handwritten scribbles and marks]

Co.
Lse.
T. No.
Sec.
T.
R.

CORRECTION

County Paynee Elev. _____
 Sec. 10 Twp. 23 Rge. 17W
 Company Colorado O & G
 Farm Name Anderson No. 4

TOPS	DEPTH	LOG	DATUM	Loc. in Sec.
Anh.				C N $\frac{1}{2}$ S $\frac{1}{2}$ SW
Tp.				
H.				
Tr.				
Dg.				
Bl.				
L.				Geol. _____
K.C.				Contr. _____
B.K.C.				
Ce.				
C.				
M.				
M.				Pool
K.				<u>GARFIELD</u>
Mz.				
Me.				
V.				
S.				
S.				
A.				
R.				
PE.				
G.				
T.D.				



Date Comm. Reported NW SE SW

Co. _____
 Lse. _____
 No. _____
 Sec. _____
 T. _____
 R. _____

County Pawnee Elev. 2097
 Sec. 10 Twp. 23 Rge. 17W
 Company Colorado O & G
 Farm Name Anderson No. 4

TOPS	DEPTH	LOG	DATUM
Anh.	<u>1135</u>		
TP.			
H.	<u>3668</u>		
Tr.			
Dg.			
BL.	<u>3280</u>		<u>1693</u>
L.	<u>3787</u>		<u>1690</u>
K.C.			
B.K.C.			
Ce.			
C. <u>Shale</u>	<u>4201</u>		<u>2104</u>
M. <u>Cg Chert</u>	<u>4218</u>		<u>2127</u>
M.			
K.			
Mz.			
Me.			
V.			
S.			
S.			
A.			
R.			
PE.			
G.			
T.D.	<u>4360</u>		

Loc. in Sec. C N $\frac{1}{2}$ S $\frac{1}{2}$ SW

Geol. _____
 Contr. Honaker

Pool Garfield

COMPLETE

MAR 28 '56

Date Comm. 2-7-56

8 5/8" @ 237/175 5 1/2" @ 4359

CO 3 2/4 4274-83 500 A PB 4270

40/ 4256-66 SP 4238 S/ 1 boph 4 hr.

500 A frac S/ 4.22 boph 4 hr.

SP 4252 40/ 4236-46 S/ 7 boph

1 hr. 500 A S/ 7.38 boph 13 hr.

frac .11 boph 11 hr. CO to 4266

Comp. 95 bopd 8% w tr.