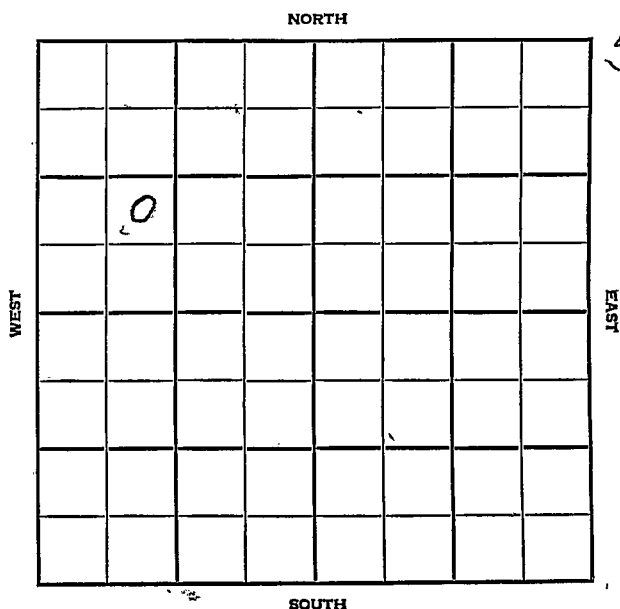


Section 10 Township 23 Range 17 WWell No. #1 Anderson "B"Company Woodriver Oil & Ref.

Pawnee

KANSAS

SEC.

TWP.

R.

10

23

17W

WELL NO.

#4 Anderson "B"

FARM

COMPANY

Woodriver Oil & Ref

CONTRACTOR

D & M Drlg


Garfield

_____ Ft. from N. Line

_____ Ft. from S. Line

_____ Ft. from E. Line

_____ Ft. from W. Line

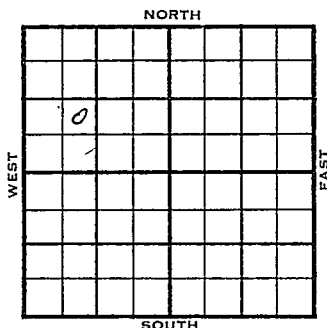

NE SW NW

1955

ELEVATION

2101

REPORT

8/17

Comm 8-12-55

8" @ 248

Drlg 2325

10/5

Comm 8-12-55

8" @ 248

Tp ~~3578~~

3578

H

3658

Dg

3689

Bl

3767

L

3775

Shly

4180

Cong Ch

4214

TD

4280

DST 4202-28 open 52 min gas to surf
in 4 min F oil in 52 min. 1140/20"

DST 4230-51 open 1/2 hr Rec 10' mud

O# DST 4248-80 open 1/2 hr Rec 5'

mud O# 5 1/2" @ 4279/55 CO 84/4202-
28 HFO in 2 hr 1250# Comp BHB F

597 BOPD

COMPLETED

County Pawnee Elev. 2101
 Sec. 10 Twp. 23 Rgs. 17W
 Company Woodriver Oil & Ref.
 Farm Name Anderson "B" No. 4

Co.

Lse.

No.

Sec.

T.

R.

TOPS	DEPTH	LOG	DATUM
Anh.			
Tp.			
H.			
Tr.			
Dg.			
Bl.			
L.			
K.C.			
B.K.C.			
Ce.			
C.			
M.			
M.			
K.			
Mz.			
Ma.			
V.			
S.			
S.			
A.			
R.			
Pe.			
G.			
TD.			

Loc. in Sec.

NE SW NW

Geol.

Contr.

D & M Delg.

Pool

Gasfield

AUG 17 '55

FIRST REPORT

Date Comm. 8-12-558" @ 248 Orlg. 2325

14

County Parnee Elev. 2101Sec. 10 Twp. 23 Rge. 17WCompany Woodraver Oil & Ref.Farm Name Anderson "B" No. 4

Co.

Sec.

No.

Sec.

T.

R.

TOPS

DEPTH

LOG

DATUM

Loc. in Sec.

Anb.

Tp.

H.

Tr.

Dg.

BL.

L.

K.C.

B.K.C.

Ce.

C.

M.

M.

K.

Mz.

Mq.

V.

S.

S.

A.

R.

PE.

G.

T.D.

NE SW NW

Geol.

Contr.

D & M Drlg.

Pools

Garfield

COMPLETE

Date Comm. 8-12-558" @ 248 DST 1202-28 open 52 min. 007 5 1955

gas to surface in 4 min. F. oil in 52 min.

11 1/2" 20" DST 1230-51 open 1/2 hr. Rec.

10' mud 0# DST 1248-80 open 1/2 hr.

Rec. 5' mud 0# 5 1/2" @ 1279/55 CO

8 1/2" 1202-28 HFO in 2 hr. 1250#

Comp. BHB F. 597 bopd