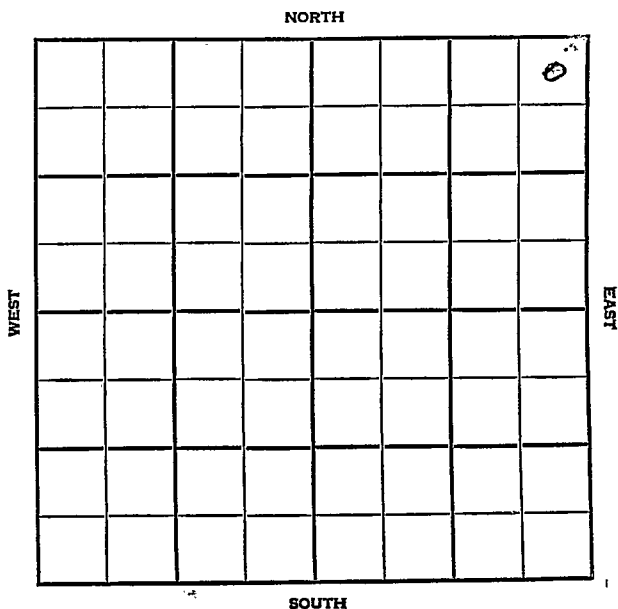


Section 10 Township 23 Range 17 WWell No. #1 KesselmanCompany Colorado C & C

Pawnee

KANSAS

SEC.	TWP.	R.
10	23	17W

WELL NO.

#1 Kesselman

FARM

COMPANY

Colorado O&G

CONTRACTOR

Garfield

440

Ft. from N. Line


Ft. from S. Line

440

Ft. from E. Line

Ft. from W. Line

NE NE NE

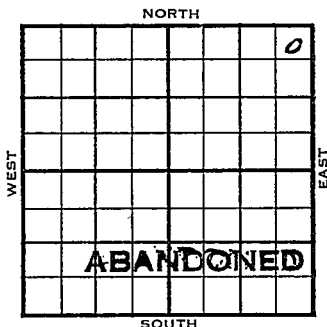

1956

ELEVATION

REPORT

2-22

MIR

County Paynee Elev. _____
 Sec. 10 Twp. 23 Rge. 17W
 Company Colorado O & G
 FarmName Kesselman No. 1

TOPS	DEPTH	LOG	DATUM	Loc. in Sec.
Anb.				NE NE NE
Tr.				WLO ¹ NL
Dg.				WLO ¹ EL
BL.				
L.				Geol.
K.C.				Contr.
B.K.C.				
Ce.				
C.				
M.				
M.				
K.				
Mz.				
Ma.				
V.				
S.				
S.				
A.				
R.				
PE.				
G.				
T.D.				

Geol. _____
 Contr. _____
 Pool _____
 Garfield _____

FEB 22 '56
 FIRST REPORT

Date Comm.

M I R

[Handwritten signature]

