

Finney

KANSAS

10

23

32W

SECTION _____ TOWNSHIP _____ RANGE _____


#1 A.J. Strasser G.U.

WELL NO. _____

The Texas Co.

COMPANY _____

NORTH

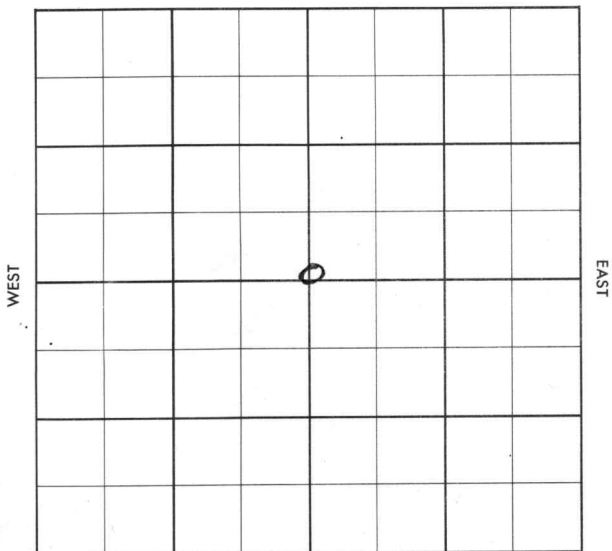

SOUTH

County Finney Elev. 2927 DF
 Sec. 10 Twp. 23 Rge. 32W
 Company The Texas Co.
 Farm Name A.J. Strasser G.U. No. 1

TOPS	DEPTH	LOG	DATUM	Loc. in Sec.
Anb.				75' N of Cen of Sec.
Tp. <u>Holt</u>	<u>2632</u>			
H. <u>Herr</u>	<u>2655</u>			
Tr. <u>Kri</u>	<u>2666</u>			
Dg. <u>Wfd</u>	<u>2730</u>			
Bl.				
L.				Geol.
K.C.				Contr.
B.K.C.				<u>Walter Kuhn Tool</u>
Ce.				Pool
C.				<u>Hugoton</u>
M.				
M.				
K.				
Mz.				
Mo.				
V.				
S.				
S.				
A.				
R.				
PE.				
G.				
TR	<u>2732</u>			



Date Comm. 9-15-56
8" @ 515 w/350, Drlg. 1161 SEP 26 '56 5 1/2
@ 2727 / 800 OCT 3 '56 CO 2732
DD 2742 ~~75~~ 75 + 10 GWP/L
1/2 B 10 GWP/L PD 2720
OCT 10 '56 72 / 2668 - 86 75 + 100 MCF/L
3 75 + 1.74 MCF + 18 GWP/L 10 \$ 1.419
MCF/L + 40 GWP/L OCT 17 '56 72 - 20
3,170 MCF/L PD 51P 370 #