

Section 10 Township 23 Range 33WWell No. #2 GardnerCompany Northern Pump Co.

			0				

NORTH

WEST

EAST

SOUTH

Sec. 10 Twp. 23 R. 33W

Well No. #2 Gardner Farm

Northern Pump Co. Company

Contractor

Hugoton


330 Ft. from N. Line

Ft. from S. Line

330 Ft. from E. Line

Ft. from W. Line

NE NE NW

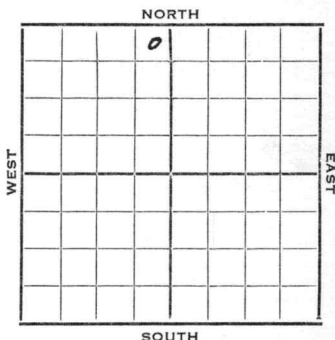

1953

Elev. 2874' REPORT

7/8

Spud 7-3-53
10" @ 349' w/225 sks
Drlg 356'

7/22

Hol 2485, Her 2513, Kr 2534, Win
2568, Tow 2632, Ft. Riley 2693, Top
3822,
DST 4135-45 1 hr, 2680' Sulphur wtr,
1200# Lans 3851'
Drlg 4592'.

7/29

Drlg.

8/5

Spud 7-3-53
D & A
TD 4912'
10" @ 349'
Hol. 2485, Her 2513, Kri. 2534, Win
2568, Tow 2632, Ft. Riley 2693,
Top. 3822
DST 4135-45 opn 1 hr, rec 2680' sul
wtr. Lans 3851'
DST 4833-83 opn 1 hr, rec 1900' sul wtr
1235#
TD 4912'
Miss 4700'
D & A

ABANDONED

County Finney State KansasSec. 10 (Blk.) 23 (Sur.) 33W Map No.Operator Northern Pump Co.Well No. 2 Farm GardnerElev. Location NE NE NW

			0				

330 Ft. From N Line NW330 Ft. From E Line Quarter1st. Report JUL 8 1953

Completion

Remarks

Spudding Date 7-3-53Drlg. Data Hugoton10" @ 349 W/225, Drlg. 356

J. G. McGEHEE

County Finney State Kansas
 Sec. 10 (Blk. 23) (Sur. 33W) Map No.
 Operator Northern Pump
 Well No. 2 Farm Gardner
 Elev. 2874 Location NE NE NW

330 Ft. From N Line NW

330 Ft. From E Line Quarter

1st. Report

Completion 406 5 1953Remarks Hugoton PoolSpudding Date 7-3-53Drlg. Data D & A TD 491210" @ 349 Hol. 2485 Her. 2513Kri. 2534 Win. 2568 Tow. 2632Ft. Riley 2693 Top. 3822 DST 4135-45open 1 hr. Rec. 2680' sul. wtr.Lens. 3851 DST 4833-83 open 1 hr.Rec. 1900' sul. wtr. 1235# TD 4912Miss. 4700D & A

J. G. McGEHEE