


Section 10 Township 23 Range 33W

Well No. #1-A Gardner

Company Northern Pump

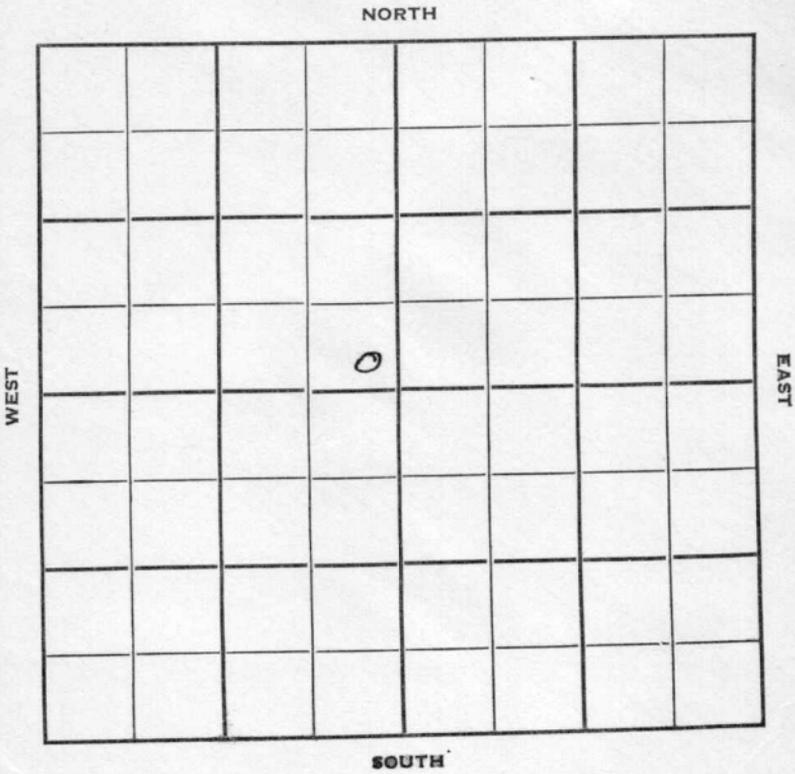

Sec. 10 Twp. 23 R. 33W

Well No. #1-A Gardner Farm _____

Northern Pump Company _____

Contractor _____


_____ Ft. from N. Line

150 Ft. from S. Line

150 Ft. from E. Line

_____ Ft. from W. Line

SE SE NW

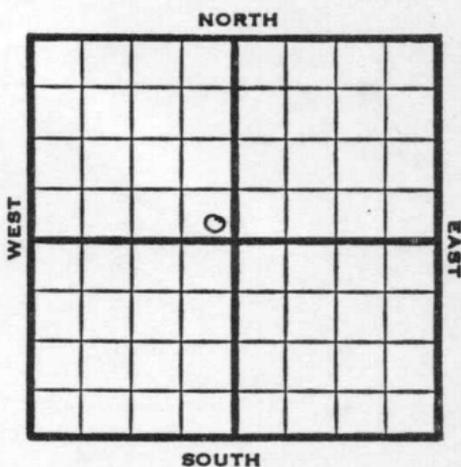

1952 Elev. 2880' REPORT

11/12 RUR
7" @ 2576'

11/20 MICT

11/27 NR

12/4 DD 2591, 2500A
102/2518-35, 1000A
96/2540-56, 60/2540-56, 3000A

12/11 25,000 Total A

12/17 Spud 10-25-52
Gas Well
TD 2591'
10" @ 333
Her. 2518, Kri 2538', Win 2570'
TD 2581
7" @ 2576 DD 2591 2500A
102/2518-35, 1000A
96/2540-56, 60/2540-56, 3000A
25000A
Comp. 14 mcf/gpd

COMPLETED

County Finney State Kansas

Sec. 10 (Blk. Twp.) 23 (Sur. Rge.) 33W Map No.

Operator Northern Pump

Well No. I-A Farm Gardner

Elev. _____ Location SE SE NW

150 Ft. From S Line NW

150 Ft. From E Line Quarter

Ist. Report NOV 12 1952

Completion _____

Remarks _____

Spudding Date _____

Drlg. Data _____

RUR

FIRST REPORT

