

KANSAS

Section 10 Township 23 Range 34-WWell No. #1 RamseyCompany Stanolind
Hugoton Pool

NORTH

				0			

WEST

EAST

SOUTH

KANSAS

Finney

Sec. 10 Twp. 23 R. 34W

Well No. #1 Ramsey Farm

Stanolind

Company

Hugoton Pool

Ft. from N. Line

150'


Ft. from S. Line

Ft. from E. Line

150'

Ft. from W. Line

SW NE

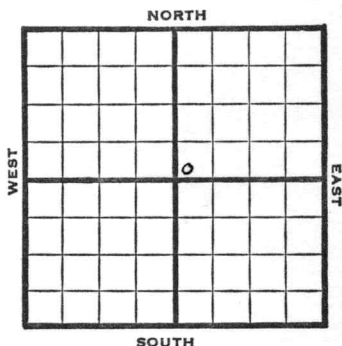

1948

Elev. 2946'

REPORT

6/16 Drlg. 800'

6/23 9"@ 907'

TD 2640'

6/29 6" @ 2600'-500 acid

210 shots 2542-67-3000 acid

228 shots 2482-2520-5500 acid

7/8 6" @ 2600'

Perf.

12,000 Acid

Gas 2,952,000

R. Pr. 2,952,000

TD 2640'

COMPLETED

Map No. _____ Sec. 10 Twp. 23 R. 34W

Well No. 1 Ramsey

Stanolind Company

SW NE **FIRST REPORT** Contractor

SECTION PLAT

_____ Ft. from N. Line

150 Ft. from S. Line

_____ Ft. from E. Line

150 Ft. from W. Line

Finney County

Location _____

Rig up _____

Drilling and Remarks:

drlg. 800

RECORD

Cased _____ in., _____ ft.

Sand _____

Gas _____

Oil _____

Total Depth _____

PRODUCTION

1st 24 hrs. Nat. _____

1st 24 hrs. after shot _____

Gas _____ Cu. Ft.

Dry Hole _____

Abandoned _____

Date

JUN 16 1948 19 S. J. LEWIS Scout

Map No. _____ Sec. 10 Twp. 23 R. 34W

Well No. 1 Ramsey

Stanolind Company

COMPLETE

Contractor

SW NE

E 1,2946

SECTION PLAT

_____ Ft. from N. Line

150 Ft. from S. Line

_____ Ft. from E. Line

150 Ft. from W. Line

Finney County

Location _____

Rig up _____

Drilling and Remarks:

6" @ 2600

Pay.
12000 acid

2,952,000 Gas

415 # R/B

RECORD

Cased _____ in., _____ ft.

Sand _____

Gas _____

Oil _____

Total Depth 2640

PRODUCTION

1st 24 hrs. Nat. _____

1st 24 hrs. after shot _____

Gas _____ Cu. Ft.

Dry Hole _____

Abandoned _____

Date

JUL 8 1948

19

S. J. LEWIS

Scout